


Give All Information Completely
Make Required Affidavit
Mail or Deliver Report to:
Conservation Division
State Corporation Commission
211 No. Broadway
Wichita, Kansas

WELL PLUGGING RECORD

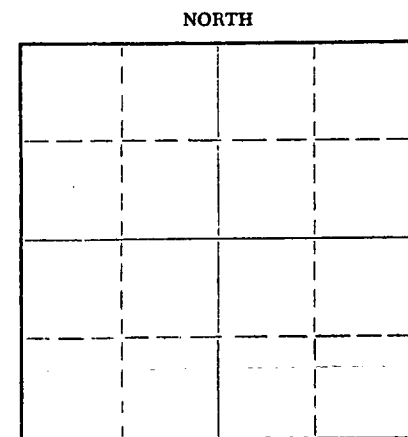


Russell County. Sec. 12 Twp. 13S Rge. (E) 15 (W)
Location as "NE/CNW/SW" or footage from lines SE SE NE
Lease Owner Abercrombie Drilling, Inc.
Lease Name JACOBS Well No. 1
Office Address 801 Union Center, Wichita, Kansas 67202
Character of Well (completed as Oil, Gas or Dry Hole) Dry
Date well completed August 6 19 64
Application for plugging filed - verbally August 5 19 64
Application for plugging approved - verbally August 5 19 64
Plugging commenced August 6 19 64
Plugging completed August 6 19 64
Reason for abandonment of well or producing formation Dry

If a producing well is abandoned, date of last production 19
Was permission obtained from the Conservation Division or its agents before plugging was commenced? Yes

Name of Conservation Agent who supervised plugging of this well
Producing formation Depth to top Bottom Total Depth of Well 3253 Feet
Show depth and thickness of all water, oil and gas formations.

OIL, GAS OR WATER RECORDS				CASING RECORD		
FORMATION	CONTENT	FROM	TO	SIZE	PUT IN	PULLED OUT
				8-5/8"	218'	None

Describe in detail the manner in which the well was plugged, indicating where the mud fluid was placed and the method or methods used in introducing it into the hole. If cement or other plugs were used, state the character of same and depth placed, from feet to feet for each plug set.
Set 1st plug at 210' w/20 sx cement & 1/4 sk hulls
Set 2nd plug at 40' w/10 sx cement & 1/2 sk hulls

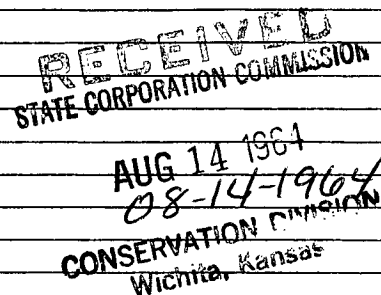

(If additional description is necessary, use BACK of this sheet)
Name of Plugging Contractor Abercrombie Drilling, Inc.
Address 801 Union Center, Wichita, Kansas 67202

STATE OF Kansas, COUNTY OF Sedgwick, ss.
I, B. Lynn Herrington, (employee of owner) or (owner) of the above-described well, being first duly sworn on oath, says: That I have knowledge of the facts, statements, and matters herein contained and the log of the above-described well as filed and that the same are true and correct. So help me God.

(Signature) B. Lynn Herrington
801 Union Center, Wichita, Kansas 67202
(Address)

SUBSCRIBED AND SWORN to before me this 13th day of August, 19 64
My commission expires June 16, 1967
Leah Faye Hefke
Notary Public.

CONTRACTOR'S WELL LOG

COMPANY: Abercrombie Drilling, Inc.
 CONTRACTOR: Abercrombie Drilling, Inc.
 FARM: JACOBS #1
 LOCATION: SE SE NE Sec. 12-13S-15W
 Russell County, Kansas
 COMMENCED: July 28, 1964
 COMPLETED: August 6, 1964

0	45	Post Rock
45	220	Shale
220	854	Shale and Shells
854	1410	Shale and Pyrite
1410	1500	Shale
1500	2707	Shale and Lime
2707	3253	Lime
3253		Rotary Total Depth

Set 8-5/8" surface casing at 218' w/140 sx common cement, 2% Calcium Chlrde

DRY AND ABANDONED

ELEVATION: 1795' D. F. & K. B.
 1790' G. L.

ELECTRIC LOG TOPS:

Anhydrite	892'	(903)
Heebner	2915'	(-1120)
Toronto	2936'	(-1141)
Lansing	2968'	(-1173)
Arbuckle	3244'	(-1449)

RECEIVED
 STATE CORPORATION COMMISSION

AUG 14 1964
 08-14-1964
 CONSERVATION DIVISION
 Wichita, Kansas

STATE OF KANSAS)
) SS
 COUNTY OF SEDGWICK)

I, B. Lynn Herrington, do hereby certify that the above and foregoing is a true and correct copy of the log of the JACOBS #1, SE SE NE Section 12-13S-15W, Russell County, Kansas, as reflected by the files of Abercrombie Drilling, Inc.

B. Lynn Herrington
 B. Lynn Herrington

Subscribed and sworn to before me, a Notary Public, in and for Sedgwick County, Kansas, this 13th day of August, 1964.

Leah Faye Hefke
 Leah Faye Hefke, Notary Public

My commission expires June 16, 1967.