

15-167-21885-00-00


STATE OF KANSAS
STATE CORPORATION COMMISSION
200 Colorado Derby Bldg.
Wichita, Kansas 67202

Form CP-4
Rev. 12-15-80

WELL PLUGGING RECORD

Give All Information Completely
Make Required Affidavit

COUNTY Russell SEC. 13 TWP. 13S RGE. 15 E/W
Location as in quarters or footage from lines:
SE SW NW

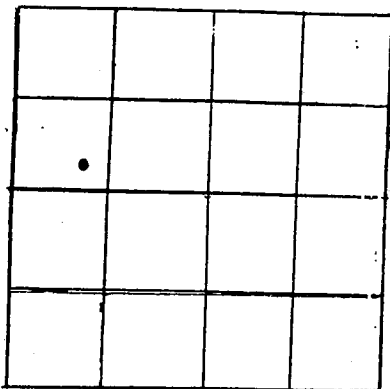

Locate Well
correctly on above
Section Platt.

Lease Owner J.M. Resources, Inc.
Lease Name Cassity Well No. 1
Office Address 425 S. Cherry St., Ste. 500 Denver, CO 80222
Character of Well (Completed as Oil, Gas or Dry Hole): Oil
Date Well Completed 4-22-82
Application for plugging filed N/A
Plugging commenced 10/7/83
Plugging completed 10/10/83

Reason for abandonment of well or producing formation non-commercial - never produced
Was permission obtained from the Conservation Division or it's Agent's before plugging was commenced? Yes

Name of Conservation Agent who supervised plugging of this well Carl Goodrow
Producing formation Lansing/Kansas City Depth to top 3003' bottom 3190' T.D. 3342
Show depth and thickness of all water, oil and gas formations.

OIL, GAS OR WATER RECORDS

Casing Record

Formation	Content	From	To	Size	Put in	Pulled Out
<u>Lansing/Kansas City</u>	<u>oil, sl. tr. gas</u>	<u>3003'</u>	<u>3190'</u>	<u>4 1/2" 9.5#</u>	<u>surface to</u>	<u>1604'</u>

Describe in detail the manner in which the well was plugged, indicating where the mud fluid was placed and the method or methods used in introducing it into the hold. If cement or other plugs were used, state the character of same and depth placed, from _____ feet to _____ feet for each plug set.

Poured sand downhole @ 2980' - Set 4 sxs cement on top.
Pumped 2 sxs hulls, 40 sxs gel & pumped 50 sxs 50/50 poz mix w/ 6% gel & 3% CaCl
Released plug - pumped 50 sxs poz mix (w/ 6% gel & 3% CaCl)
SI @ 150 psi

(If additional description is necessary, use BACK of this sheet)

Name of Plugging Contractor J.M. Resources, Inc.

STATE OF COLORADO COUNTY OF DENVER, ss.
RON MAGGARD (employee of ~~owner~~) or (~~owner~~ or operator) of the above-described well, being first duly sworn on oath, says: That I have knowledge of the facts, statements, and matters herein contained and the log of the above-described well as filed and that the same are true and correct. So help me God.

(Signature) [Signature]
425 S. Cherry #500 Denver Co
(Address) 80222

SUBSCRIBED AND SWORN TO before me this 16th day of Nov, 1983



My Commission expires: July 29, 1984
[Signature]
Notary Public.

NOV 28 1983
11-28-1983
CONSERVATION DIVISION
Wichita, Kansas