

WELL PLUGGING RECORD


STATE OF KANSAS STATE CORPORATION COMMISSION

FORMATION PLUGGING RECORD

Strike out upper line when reporting plugging off formations.

Give All Information Completely Make Required Affidavit Mail or Deliver Report to: Conservation Division State Corporation Commission 800 Bitting Building Wichita, Kansas

Russell County. Sec. 13 Twp. 13S. Rge. XXX 15 (W) Location as "NE 1/4 NW 1/4 SW 1/4" or footage from lines. SE SE NW Lease Owner The Derby Oil Company Lease Name Jellison Well No. 1 Office Address Wichita, Kansas. Character of Well (completed as Oil, Gas or Dry Hole) Dry Hole Date well completed March 19, 19 49 Application for plugging filed April 5, 19 49 Application for plugging approved March 30, 19 49 Plugging commenced March 21, 19 49 Plugging completed March 26, 19 49 Reason for abandonment of well or producing formation Dry Hole

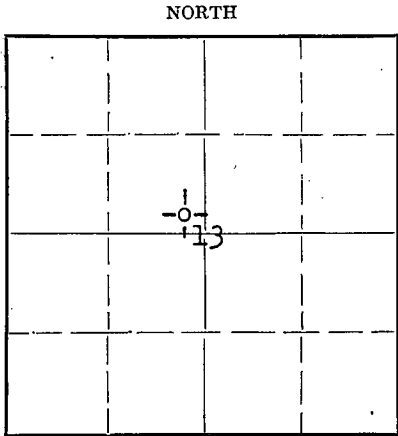

Locate well correctly on above Section Plat

Name of Conservation Agent who supervised plugging of this well. Producing formation None Depth to top Bottom Total Depth of Well 3280 Feet Show depth and thickness of all water, oil and gas formations.

OIL, GAS OR WATER RECORDS

CASING RECORD

Table with 7 columns: Formation, Content, From, To, Size, Put In, Pulled Out. Contains data for 8 5/8" and 4 1/2" casing sizes.

Describe in detail the manner in which the well was plugged, indicating where the mud fluid was placed and the method or methods used in introducing it into the hole. If cement or other plugs were used, state the character of same and depth placed, from feet to feet for each plug set.

Cement 3280 - 3274 Lane Wells plug 3274 - 3270 Heavy mud 3270 - 3260 Cement 3260 - 3200 Heavy mud 3200 - 300 Cement 300 - 260 Heavy mud 260 - 26 Cement 26 - 6 Cellar 6 - 0

Handwritten date 04-13-1949 and other markings.

(If additional description is necessary, use BACK of this sheet) Correspondence regarding this well should be addressed to The Derby Oil Company, Box 1030 Address Wichita, Kansas.


STATE OF Kansas, COUNTY OF Sedgwick, ss. J. R. Bratcher (employee of owner) of the above-described well, being first duly sworn on oath, says: That I have knowledge of the facts, statements, and matters herein contained and the log of the above-described well as filed and that the same are true and correct. So help me God.

(Signature) J. R. Bratcher Derby Oil Company, Wichita, Kansas. (Address)

SUBSCRIBED AND SWORN to before me this 12th day of April, 1949.

Ruth L. Knouse Notary Public.

My commission expires June 11, 1952.

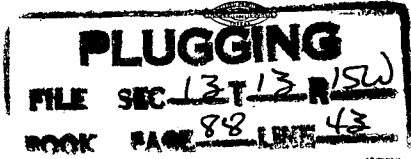

15-167-00383-00-00

DRILLER'S LOG

Company: Derby Oil Company  
Peel-Hardman Producers  
R. C. McCormick

Sec. 13 Twp. 13S Rge. 15W  
SE SE NW

County: Russell,  
Kansas

From: Jellison Well No. 1

Total Depth: 3280' (Rotary)  
Comm.: 2-27-49 Comp.: 3-11-49  
Contractor: Glenn Peel Drilling Co., Inc.

Elevation:  
Production:

Casing:  
8 5/8" 813' cem.  
4 1/2" 3279' cem.

Figures below indicate bottom of formations

Shells and Shale	0 -	260
Shale and Shells		325
Sand		380
Iron and Sand Streaks		400
Shale and Sand		520
Shale		560
Shale and Sand Streaks		600
Red, Bed, Shells and Iron Streaks		813
Shale and Shells		870
Anhydrite		905
Shale and Shells		1200
Salt and Shale		1250
Shale and Salt		1310
Shale		1540
Shale and Lime Streaks		1585
Broken Line		1785
Lime		2185
Broken Line and Shale		2550
Lime and Shale		2720
Lime		2865
Lime and Shale		2975
Lime		3280
Total Depth (Rotary)		3280

04-13-1949

This is to certify that the above information is, to the best of our knowledge, true and correct.

GLENN PEEL DRILLING COMPANY, INC.

BY: Wm. Herbert

SUBSCRIBED AND SWORN to before me this 14th day of March, 1949

My commission expires June 4, 1951

Marion M. Herber  
Notary Public

PLUGGING  
FILE SEC. 13-13-15W  
BOOK PAGE 88 LINE 42