


Give All Information Completely
Make Required Affidavit
Mail or Deliver Report to:
Conservation Division
State Corporation Commission
211 No. Broadway
Wichita, Kansas

WELL PLUGGING RECORD

NORTH

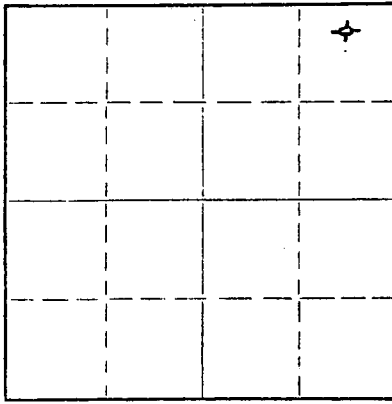

Locate well correctly on above Section Plat

Russell County. Sec. 11 Twp. 13S Rge. 15 (E) W (W)
Location as "NE/CNW/SE/SW" or footage from lines N/2 NE/4 NE/4
Lease ~~Owner~~ Operator: T. O. Gaskill
Lease Name SHAFFER Well No. 1
Office Address 308 Springer Bldg., Tulsa 19, Oklahoma
Character of Well (completed as Oil, Gas or Dry Hole) Dry Hole
Date well completed July 2, 19 62
Application for plugging filed (verbal) July 2, 19 62
Application for plugging approved (verbal) July 2, 19 62
Plugging commenced July 2, 19 62
Plugging completed July 2, 19 62
Reason for abandonment of well or producing formation Dry Hole

If a producing well is abandoned, date of last production _____ 19____
Was permission obtained from the Conservation Division or its agents before plugging was commenced? Yes

Name of Conservation Agent who supervised plugging of this well Don Truan
Producing formation _____ Depth to top _____ Bottom _____ Total Depth of Well 2770 Feet
Show depth and thickness of all water, oil and gas formations.

OIL, GAS OR WATER RECORDS

CASING RECORD

FORMATION	CONTENT	FROM	TO	SIZE	PUT IN	PULLED OUT
		0	387'	8-5/8"	387'	none

Describe in detail the manner in which the well was plugged, indicating where the mud fluid was placed and the method or methods used in introducing it into the hole. If cement or other plugs were used, state the character of same and depth placed, from _____ feet to _____ feet for each plug set.

Lower bridging plug set at 350' with 1/2 sack cotton seed hulls and with 25 sacks of regular cement mixed and dumped through the drill pipe on top of plug. Mud was pumped into hole above cement up to 35'. Top plug set at 35' with 1/4 sack of cotton seed hulls and with 10 sacks of regular cement dumped down the surface casing, filling casing up to the base of the cellar.

RECEIVED
STATE CORPORATION COMMISSION
07-09-1962
JUL 9 1962

CONSERVATION DIVISION
Wichita, Kansas

(If additional description is necessary, use BACK of this sheet)
Name of Plugging Contractor Birmingham-Bartlett Drilling Co.
Address 300 Kaufman Bldg., Wichita 2, Kansas

STATE OF Kansas COUNTY OF Sedgwick
Richard Hindery, partner of Birmingham-Bartlett Drilling Co., contractor (employee of owner) or (owner or operator) of the above-described well, being first duly sworn on oath, says: That I have knowledge of the facts, statements, and matters herein contained and the log of the above-described well as filed and that the same are true and correct. So help me God. BIRMINGHAM-BARTLETT DRILLING CO.

(Signature) By Richard Hindery Partner
300 Kaufman Bldg., Wichita 2, Kansas
(Address)

SUBSCRIBED AND SWORN TO before me this 3rd day of July, 19 62.

My commission expires October 2, 1962.

Beverly Larson
Beverly Larson Notary Public.

SHAFFER NO. 1 WELL

LOCATION: N/2 NE/4 NE/4
Section 11-13S-15W
Russell County, Kansas

SPUDED: June 27, 1962
COMPLETED: July 2, 1962

OPERATOR: T. O. Gaskill
308 Springer Bldg.
Tulsa 19, Oklahoma

CONTRACTOR: Birmingham-Bartlett Drilling Co.
300 Kaufman Bldg.
Wichita 2, Kansas

SURFACE CASING: 8-5/8" surface casing cemented
at 387' with 235 sacks cement

OIL STRING: None set. Dry hole. Plugged
on July 2, 1962.

LOG

(Figures indicate bottom of formation)

0 -	60	Post Rock
	230	Shale and Clay
	260	Sandy Shale
	305	Shale and Shells
	857	Shale
	892	Anhydrite
	1435	Shale and Red Bed
	1590	Shale and Shells
	2260	Shale and Lime
	2455	Shale
	2645	Shale and Lime
	2685	Lime
	2699	Shale
	2770	Lime
	2770	Rotary Total Depth

RECEIVED
STATE CORPORATION COMMISSION

JUL 9 1962
07-09-1962
CONSERVATION DIVISION
Wichita, Kansas

The undersigned, Richard Hindery, one of the partners of Birmingham-Bartlett Drilling Co., hereby certifies that the above is a true and correct log of the formations encountered in drilling the Shaffer No. 1 Well as shown in the daily drilling reports.

BIRMINGHAM-BARTLETT DRILLING CO.

By Richard Hindery
Richard Hindery, Partner

Subscribed and sworn to before me
this 3rd day of July, 1962.

Beverly Larson

Beverly Larson, Notary Public
My commission expires October 2, 1962.