

STATE OF KANSAS
STATE CORPORATION COMMISSION

Give All Information Completely
Make Required Affidavit
Mail or Deliver Report to:
Conservation Division
State Corporation Commission
211 No. Broadway
Wichita, Kansas

15467-00637-00-00 Form CP-4

WELL PLUGGING RECORD

Russell County. Sec. 14 Twp. 13S Rge. 15 (E) W (W)

Location as "NE/CNW/SW" or footage from lines SW SE NW

Lease Owner Operator: Christie-Stewart, Inc.

Lease Name BRUNGARDT "A" Well No. 1

Office Address 930 First Wichita National Bank Bldg., Wichita Falls, Tex.

Character of Well (completed as Oil, Gas or Dry Hole) Dry Hole

Date well completed April 11, 19 64

Application for plugging filed (Verbal) April 11, 19 64

Application for plugging approved (Verbal) April 11, 19 64


Plugging commenced April 11, 19 64

Plugging completed April 11, 19 64

Reason for abandonment of well or producing formation Dry Hole

If a producing well is abandoned, date of last production 19

Was permission obtained from the Conservation Division or its agents before plugging was commenced? Yes

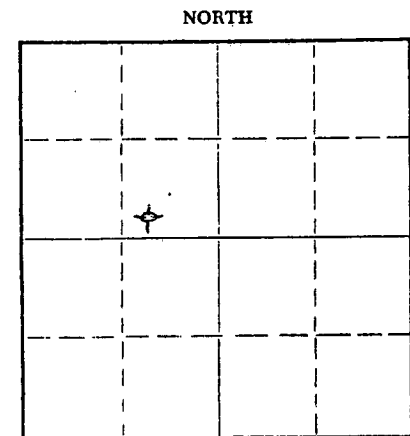

Locate well correctly on above Section Plat

Name of Conservation Agent who supervised plugging of this well Donald Truan

Producing formation Depth to top Bottom Total Depth of Well 3256 Feet

Show depth and thickness of all water, oil and gas formations.

OIL, GAS OR WATER RECORDS

CASING RECORD

FORMATION	CONTENT	FROM	TO	SIZE	PUT IN	PULLED OUT
		0	205'	8-5/8"	205'	none

Describe in detail the manner in which the well was plugged, indicating where the mud fluid was placed and the method or methods used in introducing it into the hole. If cement or other plugs were used, state the character of same and depth placed, from feet to feet for each plug set.

Plugged hole: Bottom plug set at 200' with 1/4 sack hulls and 25 sacks cement on plug; top plug set at 40' with 1/2 sack hulls and 20 sacks cement.

RECEIVED
STATE CORPORATION COMMISSION

APR 14 1964
04-14-1964
CONSERVATION DIVISION
Wichita, Kansas

(If additional description is necessary, use BACK of this sheet)

Name of Plugging Contractor Birmingham-Bartlett Drilling Co.

Address 300 Kaufman Bldg., Wichita, Kansas 67202

STATE OF KANSAS, COUNTY OF SEDGWICK
Richard Hindery, partner of Birmingham-Bartlett Drilling Co., contractor
Richard Hindery, partner of Birmingham-Bartlett Drilling Co., (employee of owner) or (owner or operator) of the above-described well, being first duly sworn on oath, says: That I have knowledge of the facts, statements, and matters herein contained and the log of the above-described well as filed and that the same are true and correct. So help me God. BIRMINGHAM-BARTLETT DRILLING CO.

(Signature) By Richard Hindery Partner
300 Kaufman Bldg., Wichita, Kansas
(Address)

SUBSCRIBED AND SWORN TO before me this 13th day of April, 19 64.

My commission expires

October 2, 1966.

Beverly Larson
Beverly Larson Notary Public.

15-167-00039-00-00

BRUNGARDT "A" NO. 1 WELL

LOCATION: SW/4 SE/4 NW/4
 Section 14-13S-15W
 Russell County, Kansas

SPUDED: 4-3-64
 COMPLETED: 4-11-64

OPERATOR: Christie-Stewart, Inc.
 930 First Wichita National Bank Bldg.
 Wichita Falls, Texas

CONTRACTOR: Birmingham-Bartlett Drilling Co.
 300 Kaufman Bldg.
 Wichita, Kansas 67202

SURFACE CASING: 8-5/8" new 20# cemented at 205' with
 140 sacks cement.

OIL STRING: None set. Dry hole. Plugged on 4-11-64.

L O G

(Figures indicate bottom of formation)

0 -	100	Post rock and clay
	205	Shale
	325	Shale and shells
	383	Hard sand
	490	Shale and shells
	865	Shale and red bed
	901	Anhydrite
	1670	Shale and shells
	2912	Shale and lime
	3032	Lime
	3077	Shale and lime
	3223	Lime
	3248	Shale and lime
	3256	Lime
	3256	Rotary total depth

RECEIVED
STATE CORPORATION COMMISSION

APR 14 1964

04-14-1964

CONSERVATION DIVISION
Wichita, Kansas

The undersigned, Richard Hindery, one of the partners of Birmingham-Bartlett Drilling Co., hereby certifies that the above is a true and correct log of the BRUNGARDT "A" NO. 1 WELL as shown in the daily drilling reports.

BIRMINGHAM-BARTLETT DRILLING CO.

By Richard Hindery
Richard Hindery, Partner

Subscribed and sworn to before me
this 13th day of April, 1964.

Beverly Larson
Beverly Larson, Notary Public
My commission expires October 2, 1966.