


WELL PLUGGING RECORD *R.F.*

Give All Information Completely  
Make Required Affidavit  
Mail or Deliver Report to:  
Conservation Division  
State Corporation Commission  
212 North Market, Insurance Bldg.  
Wichita, Kansas

Russell County, Sec. 14 Twp. 13 Rge. 15 (~~E~~) (W)  
Location as "NE/CNW/SW" or footage from lines CS 1/2 SE 1/4 SW 1/4  
Lease Owner Davidor & Davidor, Inc.  
Lease Name Brungardt Well No. 1  
Office Address Oklahoma City, Oklahoma  
Character of Well (completed as Oil, Gas or Dry Hole) Dry Hole  
Date well completed 17 November 19 65  
Application for plugging filed 17 November 19 65  
Application for plugging approved 17 November 19 65  
Plugging commenced 17 November 19 65  
Plugging completed 17 November 19 65  
Reason for abandonment of well or producing formation Dry Hole

NORTH

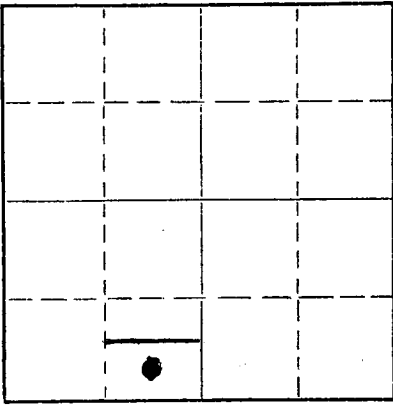

Locate well correctly on above Section Plat

If a producing well is abandoned, date of last production 19  
Was permission obtained from the Conservation Division or its agents before plugging was commenced? Yes

Name of Conservation Agent who supervised plugging of this well Don Truan  
Producing formation \_\_\_\_\_ Depth to top \_\_\_\_\_ Bottom \_\_\_\_\_ Total Depth of Well 3279 Feet  
Show depth and thickness of all water, oil and gas formations.

OIL, GAS OR WATER RECORDS

CASING RECORD

FORMATION	CONTENT	FROM	TO	SIZE	PUT IN	PULLED OUT

Describe in detail the manner in which the well was plugged, indicating where the mud fluid was placed and the method or methods used in introducing it into the hole. If cement or other plugs were used, state the character of same and depth placed, from \_\_\_\_\_ feet to \_\_\_\_\_ feet for each plug set.

Set a collar in cellar, filled hole with heavy mud and used Ha-liburton pump truck to squeeze with 80 sacks of cement.

RECEIVED  
NOV 29 1965  
11-29-1965

(If additional description is necessary, use BACK of this sheet)

Name of Plugging Contractor Burt Drilling Co.  
Address Great Bend, Kansas

STATE OF KANSAS, COUNTY OF BARTON, ss.

\_\_\_\_\_, (employee of owner) or (owner or operator) of the above-described well, being first duly sworn on oath, says: That I have knowledge of the facts, statements, and matters herein contained and the log of the above-described well as filed and that the same are true and correct. So help me God.

(Signature) \_\_\_\_\_

Great Bend, Kansas

(Address)

SUBSCRIBED AND SWORN to before me this 23rd day of November, 1965

Edwin H. Mauler

Notary Public.

My commission expires July 2, 1969



15-167-30131-06-00

DAVIDOR & DAVIDOR  
4515 North Santa Fe  
Oklahoma City, Oklahoma

Well: Brungart No. 1  
Commenced R. D.: 11/8/65  
Completed R. D.: 11/17/65  
Total Depth: 3,279' D.F.  
Casing: 168' of 8 5/8" 8rd.thd.24# Surface Pipe

Sec. 14-13-15  
Russell County, Kansas  
Elevation:  
Initial Prod:  
Contractor: BURT DRILLING  
COMPANY

Strata	Depth
Post Rock	0- 87'
Shale & Shells	87- 370
Pyrite & Sand	370- 430
Shale & Shells	430- 890
Anhydrite	890- 925
Shale & Shells	925-1544
Shale & Lime	1544-1570
Lime w/shale Streaks	1570-1740
Lime	1740-1900
Lime w/shale Streaks	1900-2150
Shale & Lime	2150-2335
Shale w/Lime Streaks	2335-2500
Shale w/Lime	2500-2523
Lime	2523-2548
Lime & Shale	2548-2730
Lime	2730-2943
Shale (Heebner)	2943-2947
Lime	2947-2950
Lime w/Shale	2950-2977
Shale w/Sand	2977-2998
Lime (Lansing)	2998-3025
Lime	3025-3195
Conglomerate	3195-3264
Lime (Arbuckle)	3264-3279

RECEIVED  
OCCUPATIONAL COMMISSION  
11-29-1965  
NOV 29 1965

I hereby certify that the above is a true and correct log of said well as reflected by daily reports.

BURT DRILLING CO.

*[Signature]*

Signed and sworn to in my presence this 23rd day of November, 1965.

*[Signature]*

My Commission Expires: July 2, 1969

