

15-195-21979-00-00

SIDE ONE

STATE CORPORATION COMMISSION OF KANSAS
OIL & GAS CONSERVATION DIVISION
WELL COMPLETION OR RECOMPLETION FORM
ACO-1 WELL HISTORY
DESCRIPTION OF WELL AND LEASE

Operator: License # 6875
Name MATTHEW OIL COMPANY
Address 200 N. Jefferson
City/State/Zip Ft. Dorado, AR 71730

Purchaser

Operator Contact Person Curtie Morrill
Phone 501-862-8546

Contractor: License # 3300
Name Lloyd Drilling

Wellsite Geologist Curtie Morrill
Phone 501-862-8546

Designate Type of Completion
New Well Re-Entry Workover
Oil Gas
XX Dry
If OKMO: old well info as follows:
Operator
Well Name
Comp. Date Old Total Depth

WELL HISTORY

Drilling Method: XX Mud Rotary Air Rotary Cable
7-8-88 7-14-88 7-15-88
Spud Date Date Reached TD Completion Date
6108 RTD
Total Depth PBTD

Amount of Surface Pipe Set and Cemented at 230 feet
Multiple Stage Cementing Collar Used? Yes No
If yes, show depth set feet
If alternate 2 completion, cement circulated
from feet depth to SX cmt
Cement Company Name
Invoice #

API NO. 15-195-21979
County Trego
30 11 24W East
Sec. Twp. Rge. West

3300 Ft North from Southeast Corner of Section
2200 Ft West from Southeast Corner of Section
(Note: Locate well in section plat below)


Lease Name McIntosh Well # 2

Field Name

Producing Formation

Elevation: Ground 2500 KD 2510

Section Plat

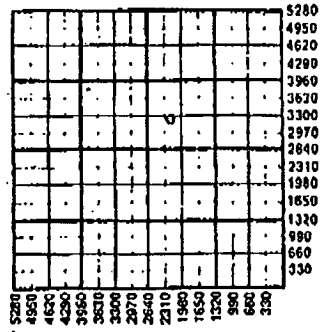

WATER SUPPLY INFORMATION

Disposition of Produced Water: Disposal
Docket # Repressuring

Questions on this portion of the ACO-1 call:
Water Resources Board (913) 296-3717
Source of Water:
Division of Water Resources Permit #
Groundwater: Ft North from Southeast Corner (Well)
Ft West from Southeast Corner of Sec Twp Rge East West
X Surface Water 660 Ft North from Southeast Corner (Stream, pond etc.) 2300 Ft West from Southeast Corner pond 25 Sec 11 Twp 25 Rge East West
Other (explain) (purchased from city, R.W.D. #)

INSTRUCTIONS: This form shall be completed in triplicate and filed with the Kansas Corporation Commission, 200 Colorado Dorby Building, Wichita, Kansas 67202, within 120 days of the spud date of any well. Rule 82-3-130, 82-3-107 and 82-3-106 apply. Information on side two of this form will be held confidential for a period of 12 months if requested in writing and submitted with the form. See rule 82-3-107 for confidentiality in excess of 12 months. One copy of all wireline logs and drillers time log shall be attached with this form. Submit CP-4 form with all plugged wells. Submit CP-111 form with all temporarily abandoned wells.

All requirements of the statutes, rules and regulations promulgated to regulate the oil and gas industry have been fully compiled with and the statements herein are complete and correct to the best of my knowledge.

Signature Curtie Morrill
Title Geologist Date 8-3-88

Subscribed and sworn to before me this 3 day of August 1988
Notary Public Harry B. Krueger
Date Commission Expires 2-1-91

K.C.C. OFFICE USE ONLY
F Letter of Confidentiality Attached
C Wireline Log Received
C Drillers Time Log Received
Distribution
KCC SKD/Rep NGPA
KGS Plug Other (Specify)

Form ACO-1 (5-86)