

FILE COPY

AFFIDAVIT OF COMPLETION FORM

CORRECTED

15-051-22736-0000 (REV) ACO-1

This form shall be filed in duplicate with the Kansas Corporation Commission, 200 Colorado Derby Building, Wichita, Kansas 67202, within ten days after the completion of the well, regardless of how the well was completed.

Attach separate letter of request if the information is to be held confidential. If confidential, only file one copy. Information on side one will be of public record and side two will then be held confidential.

Circle one: Oil, Gas, Dry, SWD, OWWO, Injection. Type and complete ALL sections. Applications must be filed for dual completion, commingling, SWD and Injection, T.A.

Attach wireline logs (i.e. electrical log, sonic log, gamma ray neutron log, etc.). KCC # (316) 263-3238. (Rules 82-2-105 & 82-2-125)

OPERATOR Liberty Enterprises, Inc.

API NO. 15-051-22,736

ADDRESS 308 West Mill

COUNTY Ellis

Plainville, Ks 67663

FIELD

**CONTACT PERSON Charles G. Comeau

PROD. FORMATION

PHONE 913-434-4686

LEASE Gayle

PURCHASER

WELL NO. #1

ADDRESS

WELL LOCATION NW NW SW NW NE SW

DRILLING Pioneer Drilling Company

330 Ft. from West Line and

CONTRACTOR

2310 Ft. from South Line of


ADDRESS 308 West Mill

the SEC. 10 TWP. 11S RGE. 17W

Plainville, Ks 67663

WELL PLAT

PLUGGING Pioneer Drilling Company (Thomas Alm)

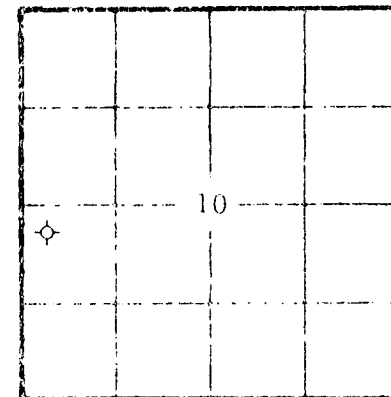

CONTRACTOR

ADDRESS 308 West Mill

KCC _____ KCS _____ (Office) _____

Plainville, Ks 67663

TOTAL DEPTH 3450' PBD

SPUD DATE 12-29-81 DATE COMPLETED 1-6-82

ELEV: GR 1798' DF 1801' KB 1803'

DRILLED WITH (CABLE) (ROTARY) (XXX) TOOLS

Amount of surface pipe set and cemented 366.43' DV Tool Used? None

AFFIDAVIT

STATE OF Kansas, COUNTY OF Rooks SE, 1,

Charles G. Comeau OF LAWFUL AGE, BEING FIRST OF MY NAME UPON MY OATH,

DEPOSES THAT HE IS Secretary-Treasurer (FOR)(OF) LIBERTY ENTERPRISES, INC.

OPERATOR OF THE Gayle LEASE, AND IS FULLY AUTHORIZED TO MAKE

THIS AFFIDAVIT FOR AND ON THE BEHALF OF SAID OPERATOR, THAT WELL NO. #1 ON

SAID LEASE HAS BEEN COMPLETED AS OF THE 6th DAY OF January, 1982, AND THAT

ALL INFORMATION ENTERED HEREIN WITH RESPECT TO SAID WELL IS TRUE AND CORRECT.

FURTHER AFFIRM AS SAITH NOT.

CONSERVATION DIVISION Wichita, Kansas 06-28-82

SUBSCRIBED AND SWORN BEFORE ME THIS 13th DAY OF January, 1982, Charles G. Comeau

MY COMMISSION EXPIRES: My Expt. Expires 11-1-82

Sharon Garvert

**The person who can be reached by phone regarding any questions concerning this information. Within 45 days of completion, a witnessed initial test by the Commission is required if the well produces more than 25 BOPD or is located in a Basic Order Pool.

SENT

make this correction on your copy please thank you