

TYPE

AFFIDAVIT OF COMPLETION FORM

ACO-1 WELL HISTORY

SIDE ONE

Two (2) copies of this form shall be filed with the Kansas Corporation Commission, 200 Colorado Derby Building, Wichita, Kansas 67202, within thirty (30) days after the completion of a well, regardless of how the well was completed.

Attach separate letter of request if the information is to be held confidential. If confidential, only file one copy. Information on Side One will be of public record and Side Two will then be held confidential.

Applications must be made on dual completion, commingling, salt water disposal, injection and temporarily abandoned wells.

X Attach one copy only wireline logs (i.e. electrical log, sonic log, gamma ray neutron log, etc.). (Rules 82-2-105 & 82-2-125) KCC# (316) 263-3238.

LICENSE #5562 EXPIRATION DATE 6-30-83

OPERATOR Liberty Enterprises, Inc. API NO. 15-167-21,969-00-00

ADDRESS 308 West Mill COUNTY Russell

Plainville, Ks 67663

FIELD

** CONTACT PERSON Charles G. Comeau PROD. FORMATION

PHONE 913-434-4686

PURCHASER LEASE Krug

ADDRESS WELL NO. #1

WELL LOCATION 700' FSL 1980' SW/4

DRILLING Pioneer Drilling Company 700 Ft. from South Line and

CONTRACTOR 308 West Mill 1980 Ft. from West Line of

ADDRESS Plainville, Ks 67663 the SW/4(Qtr.) SEC 11 TWP 13S RGE 15W

PLUGGING Pioneer Drilling Company (Tom Alm)

CONTRACTOR 308 West Mill

ADDRESS Plainville, Kansas 67663

TOTAL DEPTH 3330' PBDT

SPUD DATE 8-03-82 DATE COMPLETED 8-09-82

ELEV: GR 1804' DF 1807' KB 1809'

DRILLED WITH (CABLE) (ROTARY) (AIR) TOOLS.

DOCKET NO. OF DISPOSAL OR REPRESSURING WELL BEING USED TO DISPOSE OF WATER FROM THIS LEASE

Amount of surface pipe set and cemented 221' DV Tool Used?

THIS AFFIDAVIT APPLIES TO: (Circle ONE) - Oil, Gas, Shut-in Gas, (Dry) Disposal, Injection, Temporarily Abandoned, OWWO. Other


ALL REQUIREMENTS OF THE STATUTES, RULES AND REGULATIONS PROMULGATED TO REGULATE THE OIL AND GAS INDUSTRY HAVE BEEN FULLY COMPLIED WITH.

WELL PLAT

(Office Use Only)

KCC ☒
KGS ☒

SWD/REP ☐
PLG. ☐

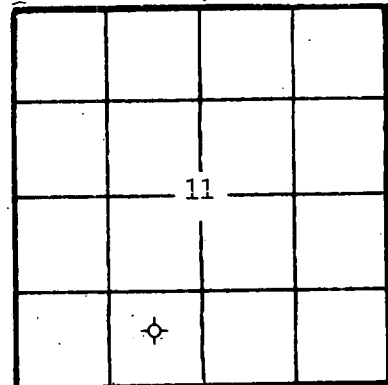


A F F I D A V I T

Charles G. Comeau, being of lawful age, hereby certifies that:

I am the Affiant, and I am familiar with the contents of the foregoing Affidavit. The statements and allegations contained therein are true and correct.

SUBSCRIBED AND SWORN TO BEFORE ME this 19th day of August, 1982.

1982.

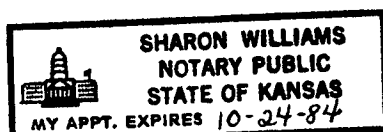

MY COMMISSION EXPIRES:

Charles G. Comeau
(Name)
Charles G. Comeau
Sharon Williams
(NOTARY PUBLIC)
Sharon Williams

** The person who can be reached by phone regarding any questions concerning this information.

RECEIVED
STATE CORPORATION COMMISSION
AUG 23 1982
08-23-1982
CONSERVATION DIVISION
Wichita, Kansas

OPERATOR Liberty Enterprises, Inc. LEASE

Krug #1

SEC. 11 TWP. 13S RGE. 15W

Show all important zones of porosity and contents thereof; cored intervals, and all drill-stem tests, including depth interval tested, cushion used, time tool open, flowing and shut-in pressures, and recoveries.

**SHOW GEOLOGICAL MARKERS, LOGS RUN,
OR OTHER DESCRIPTIVE INFORMATION.**

DST #1
3254 - 3330, 30-30-30-30
Recovery: 840' muddy water
ISIP 1082
IFP 125 - 275
FFP 326 - 426
FSIP 1065

Purpose of string	Size hole drilled	Size casing set (in O.D.)	Weight lbs/ft.	Setting depth	Type cement	Sacks	Type and percent additives
Surface Casing	12 1/4"	8 5/8"	24#	221'	common	130	2%gel 3%cc

LINER RECORD

PERFORATION RECORD

Top, ft.	Bottom, ft.	Sacks cement	Shots per ft.	Size & type	Depth interval
TUBING RECORD					
Size	Setting depth	Packer set at			

ACID, FRACTURE, SHOT, CEMENT SQUEEZE RECORD

Amount and kind of material used				Depth interval treated	
Date of first production		Producing method (flowing, pumping, gas lift, etc.)		Gravity	
RATE OF PRODUCTION PER 24 HOURS	Oil bbls.	Gas MCF	Water %	Gas-oil ratio bbls.	CFPB
Disposition of gas (vented, used on lease or sold)			Perforations		

STATE OF KANSAS
NOTARY PUBLIC
SHARON WILLIAMS