


STATE OF KANSAS
STATE CORPORATION COMMISSION

WELL PLUGGING RECORD

Give All Information Completely
Make Required Affidavit
Mail or Deliver Report to
Conservation Division
State Corporation Comm.
245 North Water
Wichita, KS 67202

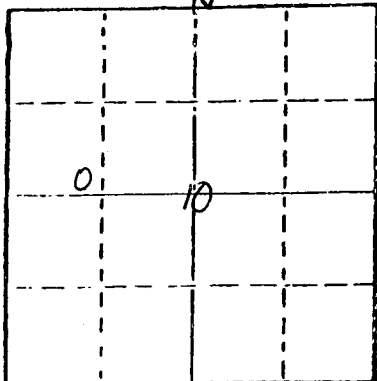

Locate well correctly on above
Section Plat

Ellis County, Sec. 10 Twp. 11S Rge. 17 E/W
Location as "NE/CNW $\frac{1}{4}$ SW $\frac{1}{4}$ " or footage from lines

SE SW NW
Lease Owner TGT Petroleum Corporation
Lease Name E. M. Simpson Well No. 1

Office Address 209 E. William, Wichita, Kansas 67202
Character of Well (Completed as Oil, Gas or Dry Hole)

Dry hole
Date Well completed Aug. 27, 1978
Application for plugging filed (verbally) Aug. 27, 1978
Application for plugging approved (verbally) Aug. 27, 1978
Plugging commenced Aug. 27, 1978
Plugging completed Aug. 27, 1978

Reason for abandonment of well or producing formation
No commercial quantity of oil or gas encountered
If a producing well is abandoned, date of last production 19

Was permission obtained from the Conservation Division or
its agents before plugging was commenced? Yes

Name of Conservation Agent who supervised plugging of this well
Producing formation Depth to top Bottom Total Depth of Well 3387
Show depth and thickness of all water, oil and gas formations.

OIL, GAS OR WATER RECORDS

CASING RECORD

FORMATION	CONTENT	FROM	TO	SIZE	PUT IN	PULLED OUT

Describe in detail the manner in which the well was plugged, indicating where the mud fluid
was placed and the method or methods used in introducing it into the hold. If cement or other
plugs were used, state the character of same and depth placed, from feet to
feet for each plug set.

Set 1st plug at 500' with 50 sacks
2nd plug at 300' with 25 sacks
3rd plug at 40' with 10 sacks
Cemented with 50-50 posmix, 2% gel.

RECEIVED
STATE CORPORATION COMMISSION

SEP 01 1978

CONSERVATION DIVISION
Wichita, Kansas

(If additional description is necessary, use BACK of this sheet)

Name of Plugging Contractor Abercrombie Drilling, Inc.

STATE OF KANSAS COUNTY OF SEDGWICK, ss.
Jack L. Partridge, Ass't. Secretary-Treasurer (employee of owner) or (owner or operator)
of the above-described well, being first duly sworn on oath, says: That I have knowledge of
the facts, statements, and matters herein contained and the log of the above-described well
as filed and that the same are true and correct. So help me God.

(Signature)


Jack L. Partridge

801 Union Center, Wichita, Kansas 67202
(Address)

SUBSCRIBED AND SWORN TO before me this 31st day of August, 1978

Sandra Richman
Sandra Richman Notary Public.

My commission expires July 21, 1979

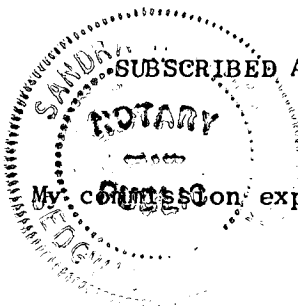

OPERATOR: TGT Petroleum Corporation
 CONTRACTOR: Abercrombie Drilling, Inc.
 WELL NAME: E. M. Simpson #1
 LOCATION: SE SW NW Section 10-11S-17W
 Ellis County, Kansas
 SPUD DATE: August 18, 1978
 COMPLETION DATE: August 27, 1978

0	85	Surface clay & shale
85	360	Surface sand & shale
360	1030	Sand & shale
1030	1064	Anhydrite
1064	1722	Shale
1722	2955	Shale & lime
2955	3240	Lime
3240	3305	Lime & shale
3305	3387	Lime
	3387	Rotary Total Depth

Spud hole at 10:00 p.m., August 18, 1978. Drilled 360' of 12 1/4 hole. Ran 9 joints of 8-5/8" - 28# casing. Set at 359' K.B. Cemented with 300 sacks of common cement, 3% CaCl, 2% gel. Cement did circulate. Plug was down at 9:15 a.m., August 19, 1978.

T.D. 3387'. Set first plug at 500' with 50 sacks, second plug at 300' with 25 sacks, third plug at 40' with 10 sacks. Cemented with 50-50 posmix, 2% gel. Plug was down at 8:00 a.m., August 27, 1978.

SAMPLE TOPS:

Anhydrite 1030' (+775)
 B/Anhydrite 1064' (+741)

RECEIVED
 STATE CORPORATION COMMISSION
 SEP 01 1978

CONSERVATION DIVISION
 Wichita, Kansas

STATE OF KANSAS)
) ss
 COUNTY OF SEDGWICK)

Jack L. Partridge, Assistant Secretary-Treasurer of Abercrombie Drilling, Inc., does hereby state that the above and foregoing is a true and correct copy of the log of the E. M. Simpson #1, SE SW NW Section 10-11S-17W, Ellis County, Kansas.

ABERCROMBIE DRILLING, INC.

By Jack L. Partridge
 Jack L. Partridge,
 Assistant Secretary-Treasurer

Subscribed and sworn to before me, a Notary Public, in and for the county and state aforesaid, as of this 31st day of August, 1978.

Sandra Richman
 Sandra Richman, Notary Public

