

WELL PLUGGING RECORD

Give All Information Completely
Make Required Affidavit
Mail or Deliver Report to
Conservation Division
State Corporation Comm.
200 Colorado Derby Bldg.
202 W. 1st St.
Wichita, KS 67202

Location as Ellis County Sec. 10 Twp. 11s Rge. 17 N/W
Location as "NE/CNW/SW" or footage from lines NE
NW SW A08 rcc

Lease Owner Liberty Enterprises, Inc.
Lease Name Gail Well No. #1
Office Address 308 West Mill Plainville, Ks 67663
Character of Well (Completed as Oil, Gas or Dry Hole) Dry Hole


Date Well completed January 6 1981
Application for plugging filed January 6 1981
Application for plugging approved January 6 1981
Plugging commenced 4:30 A.M. January 6 1981
Plugging completed 6:00 A.M. January 6 1981
Reason for abandonment of well or producing formation No Commercial Production

If a producing well is abandoned, date of last production 19

Was permission obtained from the Conservation Division or its agents before plugging was commenced? Yes

Name of Conservation Agent who supervised plugging of this well Marion Schmidt
Producing formation _____ Depth to top _____ Bottom _____ Tl. Depth of Well _____
Show depth and thickness of all water, oil and gas formations.

locate well correctly
on above
Section Plot

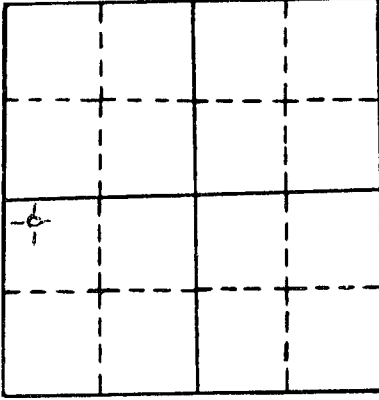

OIL, GAS OR WATER RECORDS

CASING RECORD

FORMATION	CONTENT	FROM	TO	SIZE	PUT IN	PULLED OUT
Surface Casing	60-40 pos	0'	366.43'	8 5/8"	366.43'	0'

Describe in detail the manner in which the well was plugged, indicating where the mud fluid was placed and the method or methods used in introducing it into the hold. If cement or other plugs were used, state the character of same and depth placed, from _____ feet to _____ feet for each plug set.

- Plug #1 720' with 70sxs
- Plug #2 310' with 40sxs
- Plug #3 40' with 10sxs

10sxs in rathole

Total---130sxs 50-50 pos 4%gel 3%cc


P.D. @ 6:00 A.M. 1-6-82

(If additional description is necessary, use BACK of this sheet)

Name of Plugging Contractor Pioneer Drilling Co, Inc.
308 West Mill Plainville, Ks 67663


STATE OF Kansas COUNTY OF Rooks, ss.

David L. Comeau (employee of owner) or (owner or operator) of the above described well, being first duly sworn on oath, says: That I have read the facts, statements, and matters herein contained and the log of the above described well is filed and that the same are true and correct. So help me God.

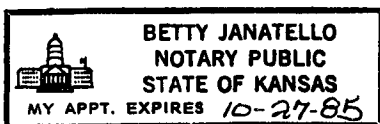

(Signature) David L. Comeau
(Address) 308 W Mill Plainville, Ks.

SUBSCRIBED AND SWORN TO before me this 8th day of January 1981

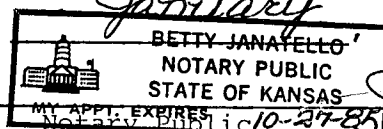

My commission expires 10-27-85

RECEIVED
STATE CORPORATION COMMISSION
JAN 21 1982
Wichita, Kansas
Betty Janatello