


STATE OF KANSAS
STATE CORPORATION COMMISSION
Give All Information Completely
Make Required Affidavit
Mail or Deliver Report to:
Conservation Division
State Corporation Commission
800 Bittling Building
Wichita, Kansas

WELL PLUGGING RECORD

NORTH

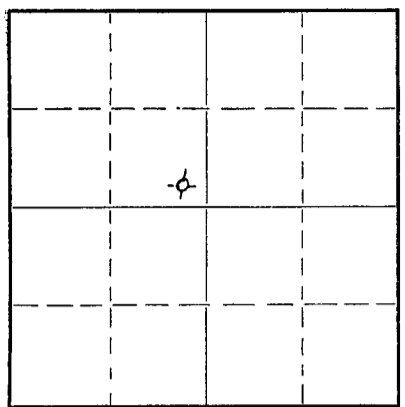

Locate well correctly on above Section Plat

Ellis County. Sec. 13 Twp. 11S. Rge. 17 (W)
Location as "NE/CNW $\frac{1}{4}$ SW $\frac{1}{4}$ " or footage from lines Sec. SE $\frac{1}{4}$ NW $\frac{1}{4}$
Lease Owner W. H. Black et al
Lease Name Fred Cress Well No. 1
Office Address 304 Union National Bank Bldg., Wichita 2, Kansas
Character of Well (completed as Oil, Gas or Dry Hole) Dry Hole
Date well completed July 10 19 49
Application for plugging filed July 11 19 49
Application for plugging approved July 12 19 49
Plugging commenced July 10 19 49
Plugging completed July 10 19 49
Reason for abandonment of well or producing formation Dry Hole

If a producing well is abandoned, date of last production 19...
Was permission obtained from the Conservation Division or its agents before plugging was commenced? Yes

Name of Conservation Agent who supervised plugging of this well C. D. Stough
Producing formation Depth to top Bottom Total Depth of Well 3380 Feet
Show depth and thickness of all water, oil and gas formations.

OIL, GAS OR WATER RECORDS

CASING RECORD

Formation	Content	From	To	Size	Put In	Pulled Out
				8-5/8"	560'	X

Describe in detail the manner in which the well was plugged, indicating where the mud fluid was placed and the method or methods used in introducing it into the hole. If cement or other plugs were used, state the character of same and depth placed, from 0 feet to 3380 feet for each plug set.

Filled hole with heavy mud to 250 feet. Pushed bottom plug to 200 feet; cemented with 15 sacks of Lone Star cement; pushed top plug to 40 feet; cemented with 15 sacks Lone Star Cement.

RCW
07-20-49

(If additional description is necessary, use BACK of this sheet)

Correspondence regarding this well should be addressed to W. H. Black, 304 Union National Bank Bldg., Wichita 2, Kansas

STATE OF Kansas, COUNTY OF Sedgwick, ss.
Leon F. Huff, Attorney-in-Fact for W. H. Black (owner or operator) of the above-described well, being first duly sworn on oath, says: That I have knowledge of the facts, statements, and matters herein contained and the log of the above-described well as filed and that the same are true and correct. So help me God.

(Signature) Leon F. Huff
1223 Monroe, Great Bend, Kansas (Address)

SUBSCRIBED AND SWORN to before me this 19th day of July, 19 49
Mildred Hobbs Notary Public

My commission expires November 5, 1951

22-5133-s 9-48-10M

PLUGGING
FILE SEC 13 T 11 R 17
BOOK PAGE 104 LINE 37

DRILLING LOG

OPERATOR: W. H. Black LOCATION: Sec SE NW
 FARM NAME: Fred Cress Section 13-11E-17W
 WELL NUMBER: 1 Ellis County, Kansas
 CONTRACTOR: W. H. Black CASING RECORD:
 8-5/8" @ 560'
 ROTARY COMMENCED: June 29, 1949 Gen. w/300 sacks
 ROTARY COMPLETED: July 19, 1949
 ELEVATION: 1826 B.F. INITIAL POTENTIAL: D & A

Figures denote bottom of formations

Shale and Shells	185		
Post Rock Shale	395		
Shale and Shells	620		
Sand	675		
Red Bed and Sand	780	Anhydrite	1025
Sand and Red Rock	1025	Topeka	2700
Anhydrite	1060	Kansas City	3017
Sand	1135	Conglomerate	3310
Red Bed, Lime and Shale	1340		
Shale, Lime, Shell	1590		
Lime and Shale	1720		
Shale and Lime	1940		
Lime and Shale	2560		
Shale and Lime	2633		
Lime and Shale	2845		
Lime and Iron	2875		
Lime	3380		
Total Rotary Depth			

STATS OF KANSAS)
 SEDGWICK COUNTY) SS

I hereby certify that the foregoing is, to the best of my knowledge and belief, a full, true and correct drilling log as shown by the daily drilling reports in connection with the aforesaid well.

Leon F. Huff
 Leon F. Huff,
 Attorney-in-Fact for W. H. Black

Subscribed and sworn to before me, the undersigned, a Notary Public, this 19th day of July, 1949.

Mildred Hobbs
 Notary Public

My commission expires November 5, 1951.

PLUGGING
 FILE SEC 13 T 11 R 7W
 BOOK PAGE 104 LINE 27

RECEIVED
 JUL 29 1949
 STATE DEPARTMENT
 COMMISSIONER
 KANSAS