


RECEIVED
AUG 14 1974

STATE OF KANSAS
STATE CORPORATION COMMISSION

File All Information Completely
State Required Affidavit
Attest Before Report to
Conservation Division
State Corporation Commission

P. O. Box 17027
Wichita, Kansas 67217

WELL PLUGGING RECORD GENERAL OFFICE

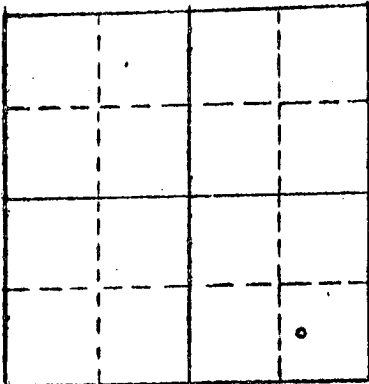

Locate well correctly on above
Section Plat

Ellis County, Sec. 13 Twp. 11 Rge. 17 (E) (W)
Location as "NE/CN/WSW" or footage from lines G W/2 SE SE
Lease Owner Lario Oil & Gas
Lease Name P. Cress #2 Well No.
Office Address Wichita, Kansas 67202
Character of Well (completed as Oil, Gas or Dry Hole) Oil
Date well completed April 6 19 40
Application for plugging filed May 3 19 74
Application for plugging approved May 6 1974
Plugging commenced 7/29/74 19
Plugging completed 8/1/74 19
Reason for abandonment of well or producing formation depleted.

If a producing well is abandoned, date of last production August 30 19 73
Was permission obtained from the Conservation Division or its agents before plugging was commenced? yes

Name of Conservation Agent who supervised plugging of this well Massey
Producing formation Depth to top Bottom Total Depth of Well 3393 Feet
Show depth and thickness of all water, oil and gas formations.

OIL, GAS OR WATER RECORDS

CASING RECORD

FORMATION	CONTENT	FROM	TO	SIZE	PUT IN	PULLED OUT
				8-5/8	1078	none
				5-3/16	3387	1902'

Describe in detail the manner in which the well was plugged, indicating where the mud fluid was placed and the method or methods used in introducing it into the hole. If cement or other plugs were used, state the character of same and depth placed, from feet to feet for each plug set.

Checked hole, could only get down to 2000'. Ran bailer and had no luck. Pushed plug to 2010' and sanded to 2000', ran 4 sacks cement. Checked hole to 1945', shot pipe at 1911' and pulled 61 joints. Bailed hole to 425', set rock bridge to 415' and filled hole with 6 yards ready mix. Tallied pipe.

PLUGGING COMPLETE

RECEIVED
STATE CORPORATION COMMISSION

AUG 15 1974

CONSERVATION DIVISION
Wichita, Kansas

(If additional description is necessary, use BACK of this sheet)
Name of Plugging Contractor KNIGHT CASING PULLING CO., INC.
Address CHASE, KANSAS


STATE OF KANSAS COUNTY OF RICE ss.
NOEL J. KNIGHT

(employee of owner) or (owner or operator) of the above-described well, being first duly sworn on oath, says: That I have knowledge of the facts, statements, and matters herein contained and the log of the above-described well as filed and that the same are true and correct. So help me God.

(Signature) Noel Knight
CHASE, KANSAS

Subscribed and Sworn to before me this 12th day of August 1974

Margaret Melcher
Notary Public.

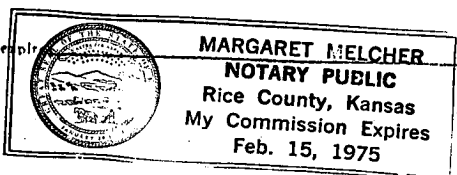

Pearl Cross # 2

Con. W $\frac{1}{2}$ SE $\frac{1}{4}$ SE $\frac{1}{4}$ Sec. 13-11s-17W
Ellis County, Kansas

Drilled for: Lario Oil & Gas Company
Drilled by: Springrose Drilling Company

Casing Record:

12 $\frac{1}{2}$ " 60'
8 5/8" 1083'
5 $\frac{1}{2}$ " 3386'

Drilling Commenced: April 6, 1940
Drilling Completed: April 27, 1940

<u>FORMATION</u>	<u>DEPTH</u>
surface clay and sand	75
sandy shale	100
shale	215
shale & shells	480
sand & shells	575
shale & lime shells	738
red beds	835
red beds & shale	915
shale & lime	1040
lime & iron pyrites	1065
anhydrite	1110
red beds	1350
shale & shells	1480
shale & salt	1665
shale & shells	1705
shale & lime shells	1780
broken lime	1900
shale & shells	1985
broken lime & shale	2075
broken lime	2200
shale & shells	2245
broken lime	2350
shale	2375
lime & shale	2425
broken lime	2530
shale	2790
shale & shells	2815
lime	3055
shale	3070
lime	3110
lime & shale	3160
lime	3281
shale	3293
lime	3310
broken lime	3365
green shale	3384
sandy pyrites	3386
lime	3391 T.D.

RECEIVED
STATE CORPORATION COMMISSION
MAY 6 - 1974
CONSERVATION DIVISION
Wichita, Kansas

STATE OF KANSAS

SS

COUNTY OF SEDGWICK

I, the undersigned, being duly sworn on oath, state that the above and within statement is a true and correct record and log of the well drilled on the location above described, to the best of my knowledge and belief.

A. K. B. Cantor

Subscribed and sworn to before me this 9th day of May 1940.

W. B. Beedle

Notary Public

My Commission Expires: July 31, 1941