


STATE OF KANSAS
STATE CORPORATION COMMISSION

WELL PLUGGING RECORD

Give All Information Completely
Make Required Affidavit
Mail or Deliver Report to:
Conservation Division
State Corporation Commission
800 Bitting Building
Wichita, Kansas

Ellis County. Sec. 13 Twp. 11S Rge. 17W (E) (W)
Location as "NE/CNW/SW" or footage from lines C N/2 SW/4 NE/4
Lease Owner West Supply Company B-H-P AND KCC
Lease Name Cress Well No. 1
Office Address Chase, Kansas
Character of Well (completed as Oil, Gas or Dry Hole) Oil
Date well completed July 15 1948
Application for plugging filed July 7 (Oral) 1952
Application for plugging approved _____ 19____
Plugging commenced July 7 1952
Plugging completed July 12 1952
Reason for abandonment of well or producing formation Ceased production

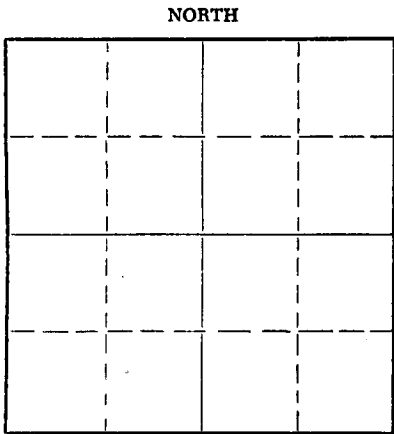

Locate well correctly on above
Section Plat

If a producing well is abandoned, date of last production March 1952
Was permission obtained from the Conservation Division or its agents before plugging was commenced? Yes

Name of Conservation Agent who supervised plugging of this well Eldon Petty
Producing formation Arbuckle Depth to top 3330' Bottom 1' Total Depth of Well 3356' Feet
Show depth and thickness of all water, oil and gas formations.

OIL, GAS OR WATER RECORDS

CASING RECORD

FORMATION	CONTENT	FROM	TO	SIZE	PUT IN	PULLED OUT
Kansas City	little oil		3069'	5-1/2"	3355'	2687'
Arbuckle	oil & water		3355'	8-5/8"	568'	None

Describe in detail the manner in which the well was plugged, indicating where the mud fluid was placed and the method or methods used in introducing it into the hole. If cement or other plugs were used, state the character of same and depth placed, from _____ feet to _____ feet for each plug set.

Ran 4 sacks of cement at 3356'. Pumped in 20 sacks of jell and 80 sacks of cement into surface pipe. Checked in and found top of cement at 15'. Filled to top with 5 sacks of cement. Plugging completed.

(If additional description is necessary, use BACK of this sheet)


Name of Plugging Contractor West Supply Company
Address Chase, Kansas

STATE OF Kansas, COUNTY OF Rice, ss.
Edward E. O'Brien (employee of owner) or (owner or operator) of the above-described well, being first duly sworn on oath, says: That I have knowledge of the facts, statements, and matters herein contained and the log of the above-described well as filed and that the same are true and correct. So help me God.


(Signature) Edward E. O'Brien
Chase, Kansas (Address)

SUBSCRIBED AND SWORN to before me this 5 day of August, 1952

My commission expires Dec 5-1954

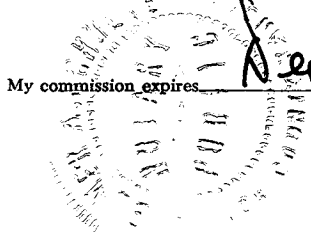

24-2675-S 2-52-20M

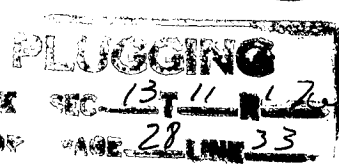

08-07-52
CONSERVATION DIVISION
WICHITA, KANSAS

DRILLING LOG

OPERATOR: W. H. Black
 FARM NAME: Cress
 WELL NUMBER: 2

LOCATION: C N/2 SW/4 NE/4
 Sec. 13-11S-17W
 Ellis County, Kansas

ROTARY COMMENCED: June 28, 1948
 ROTARY COMPLETED: July 10, 1948

CASING RECORD:
 8 5/8" @ 568'
 Cem. 300 sacks
 5 1/2" @ 3355'
 Cem. 100 sacks

CABLE COMMENCED: July 12, 1948
 CABLE COMPLETED: July 15, 1948

ELEVATION: 1830 DF

INITIAL POTENTIAL: 82 BO

Figures denote bottom of formations

<u>Formation</u>	<u>Depth</u>	<u>Tops</u>	
Soil, Sand and Shale	200	Anhydrite	1025
Shale Shells	315	Lansing-Kansas City	3069
Sand	500	Cherty Conglomerate	3289
Shale, Shells and Iron Streaks	569	Simpson	3322?
Iron	590	Arbuckle	3355
Sand and Red Rock	1025		
Anhydrite	1060		
Red Bed Sand	1325		
Shale, Lime, Shells	1390		
Salt, Shale, Shells	1510		
Lime and Shale	1735		
Lime and Shale	2030		
Lime	2085		
Shale and Shells	2200		
Lime and Shale	2775		
Lime	3285		
Cherty Conglomerate	3321		
Sandy Shale	3330		
Lime Shale and Chert	3355		
Rotary Total Depth			
Total Depth			

STATE OF KANSAS)
 SEDGWICK COUNTY) SS

RECORDED
 STATE COMMISSION
 JUL 30 1948
 CONSERVATION
 WICHITA

I, Leon F. Huff, Attorney in Fact for W. H. Black, do hereby certify that the foregoing is, to the best of my knowledge and belief, a full, true and correct drilling log as shown by the daily drilling reports in connection with the, afore-said well.

Leon F. Huff
 Leon F. Huff

Subscribed and sworn to before me, the undersigned, a Notary Public, this 30th day of August, 1948.

Mildred Hobbie
 Notary Public

My commission expires Nov. 5, 1951.

PLUGGING
 FILE SEC-13T-LLR-170
 BOOK PAGE 28 LINE 33