


WELL PLUGGING RECORD

Give All Information Completely
Make Required Affidavit
Mail or Deliver Report to:
Conservation Division
State Corporation Commission
212 North Market, Insurance Bldg.
Wichita, Kansas

Ellis County. Sec. 13 Twp. 11S Rge. 17 (E) W (W)
Location as "NE/CNW/SW" or footage from lines C - SE - NW SE NE ANB KCC
Lease Owner Sinclair Oil & Gas Company
Lease Name H. I. Cress Well No. 2
Office Address P. O. Box 521 - Tulsa 2, Oklahoma
Character of Well (completed as Oil, Gas or Dry Hole) Oil Well
Date well completed August 29, 19 37
Application for plugging filed August 30, 19 63
Application for plugging approved September 3, 19 63
Plugging commenced September 9, 19 63
Plugging completed September 10, 19 63
Reason for abandonment of well or producing formation Oil depleted in Arbuckle formation & unable to test Lans. K.C. - bad casing.
If a producing well is abandoned, date of last production February 19 53
Was permission obtained from the Conservation Division or its agents before plugging was commenced? Yes

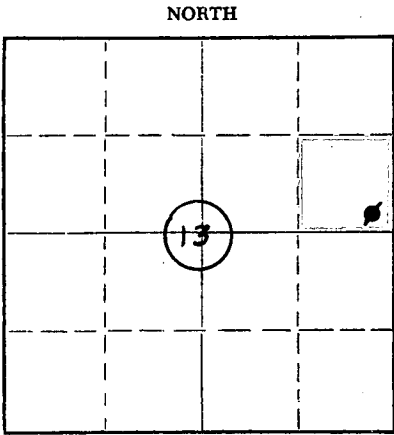

Locate well correctly on above Section Plat

Name of Conservation Agent who supervised plugging of this well Mr. Eldon Petty - Hays, Kansas
Producing formation Arbuckle Depth to top 3331 Bottom 3423 Total Depth of Well 3423 Feet
Show depth and thickness of all water, oil and gas formations.

OIL, GAS OR WATER RECORDS

CASING RECORD

FORMATION	CONTENT	FROM	TO	SIZE	PUT IN	PULLED OUT
Arbuckle	Oil	3331	3423	16"	104	-
				9 5/8"	1020	-
				7"	3331	1500
				5 1/2"	63	-

Describe in detail the manner in which the well was plugged, indicating where the mud fluid was placed and the method or methods used in introducing it into the hole. If cement or other plugs were used, state the character of same and depth placed, from _____ feet to _____ feet for each plug set.

Set Lane-Wells 7" bridge plug @ 3300 feet. Pumped mud & mudded hole from 3300 feet to 450 feet. ~~to 410 feet.~~ Spotted 20 sacks cement plug from 450' to 410 feet. Mudded hole from 410 feet to 180 feet. Spotted 20 sks cement plug from 180' to 140 feet. Mudded hole from 140 feet to 30 feet. Capped hole with 10 sacks cement. Top of cap plug was six feet below ground level.

RECEIVED
STATE CORPORATION COMMISSION

SEP 17 1963

CONSERVATION DIVISION
Wichita, Kansas

(If additional description is necessary, use BACK of this sheet)
Name of Plugging Contractor Knight Casing Pulling Company - License No. 436
Address P. O. Box 405 - Chase, Kansas.

STATE OF Kansas, COUNTY OF Barton, ss.
J. F. Donham

(employee of owner) or (owner or operator) of the above-described well, being first duly sworn on oath, says: That I have knowledge of the facts, statements, and matters herein contained and the log of the above-described well as filed and that the same are true and correct. So help me God

(Signature) *J. F. Donham*

Route # 1 - Great Bend, Kansas 67530

(Address)

SUBSCRIBED AND SWORN to before me this 16 day of September, 1963

My Commission Expires July 12, 1967

My commission expires

Fred E. Vobornik
Notary Public.



