


STATE OF KANSAS  
STATE CORPORATION COMMISSION  
CONSERVATION DIVISION  
P. O. BOX 17027  
WICHITA, KANSAS 67217

FORM CP-4

WELL PLUGGING RECORD

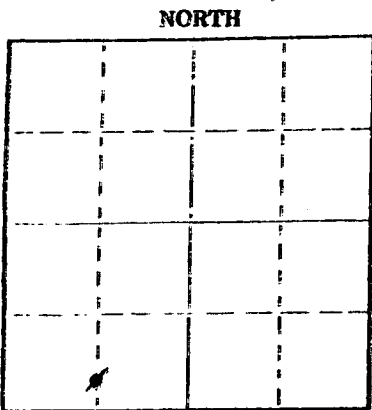

Locate well correctly on above Section Plot

Ellis County. Sec. 13 Twp. 11 Rge. (E) 17 (W)

Location as "NE/CNW/SW" or footage from lines CSL S/2 SW

Lease Owner Lario Oil & Gas Company AWS KCC

Lease Name F. Cress Well No. 4

Office Address 301 S. Market, Wichita, Kansas 67202

Character of Well (completed as Oil, Gas or Dry Hole) Oil

Date well completed November 23 1939

Application for plugging filed May 3 19 74

Application for plugging approved May 6, 19 74

Plugging commenced August 9 19 74

Plugging completed August 15 19 74

Reason for abandonment of well or producing formation Depleted

If a producing well is abandoned, date of last production February 29 19 68

Was permission obtained from the Conservation Division or its agents before plugging was commenced? Yes

Name of Conservation Agent who supervised plugging of this well Leo Massey

Producing formation Arbuckle Depth to top \_\_\_\_\_ Bottom \_\_\_\_\_ Total Depth of Well 3383 Feet

Show depth and thickness of all water, oil and gas formations.

OIL, GAS OR WATER RECORDS

CASING RECORD

FORMATION	CONTENT	FROM	TO	SIZE	FUT IN	PULLED OUT
				8 5/8	1083	
				5 1/2	3376	2530'

Describe in detail the manner in which the well was plugged, indicating where the mud fluid was placed and the method or methods used in introducing it into the hole. If cement or other plugs were used, state the character of same and depth placed, from \_\_\_\_\_ feet to \_\_\_\_\_ feet for each plug set.

Checked bottom, ran sand to 3350', 3350 to 3317' ran 4 sacks cement. Loaded hole, shot pipe at 2700', 2585', pulled 105 joints. Set 10' rock bridge at 420' and ran 6 yards ready mix.

RECEIVED  
STATE CORPORATION COMMISSION  
SEP 9 1974  
CONSERVATION DIVISION  
Wichita, Kansas

(If additional description is necessary, use BACK of this sheet)  
Name of Plugging Contractor Knight Casing Pulling Co., Inc.  
Address Chase, Kansas

STATE OF Kansas COUNTY OF Sedgwick ss.  
M. E. Kraft, employee (employee of owner) or (owner or operator) of the above-described

well, being first duly sworn on oath, says: That I have knowledge of the facts, statements, and matters herein contained and the log of the above-described well as filed and that the same are true and correct. So help me God.

(Signature) M E Kraft  
301 S. Market, Wichita, Kansas 67202  
(Address)

Subscribed and sworn to before me this 6th day of September, 19 74

My commission expires July 21, 1978 Frances Leslie Notary Public.



F. Cress # 4C Well

Gen. S $\frac{1}{2}$  S $\frac{1}{2}$  SW $\frac{1}{4}$  Section 13-11S-17W  
Ellis County, Kansas

Drilled for: Lario Oil & Gas Company  
Drilled by: Springrose Drilling Company

Casing Record:

8" 1083'  
5" 3376'

Drilling Commenced: November 23, 1939  
Drilling Completed: December 14, 1939

1983

<u>FORMATION</u>	<u>DEPTH</u>
surface clay and sand	80
shale	150
shale & shells	595
broken lime	655
sand	725
shale & shells	820
broken lime	945
red shale	1060
blue shale	1070
anhydrite	1119
red bed & shale	1240
shale & shells	1430
shale & salt	1640
shale & shells	1720
lime & shells	1750
broken lime	1900
lime & shale	1945
broken lime	2070
lime & sticky shale	2110
lime	2145
shale	2250
broken lime	2270
shale & lime	2335
shale	2405
shale & lime	2500
shale & shells	2550
sandy shale	2575
shale	2675
shale & shells	2730
shale	2830
lime	2935
lime & chert	2970
lime	3040
lime & shale	2095
broken lime	3140
lime	3355
lime - conglomerate & green shale	3382
chert & dolomite	3385
Steel Line Measurement	
correction to	3376
lime	3383 TOTAL DEPTH

RECEIVED  
STATE CORPORATION COMMISSION  
MAY 6 - 1974  
CONSERVATION DIVISION  
Wichita, Kansas

1983  
1070  
813-49

STATE OF KANSAS

SS

COUNTY OF SEDGWICK

I, the undersigned, being duly sworn on oath, state that the above and within statement is a true and correct record and log of the well drilled on the location above described, to the best of my knowledge and belief.

W. J. Benson

Subscribed and sworn to before me this 28 day of December 1939.

John Sedgwick  
Notary Public

My Commission Expires: July 31 - 1941