

* CARD MUST BE TYPED
Renewal

State of Kansas

NOTICE OF INTENTION TO DRILL

CARD MUST BE SIGNED
* Extension

(see rules on reverse side)

Starting Date ... 3-14-88 ... month day year

API Number 15- 051-24,521-0000

OPERATOR: License # # 4794
Name Big Bear Resources, Inc.
Address 1105 E. 30th, Suite B
City/State/Zip Hays, Kansas 67601
Contact Person Isadore P. Kisner
Phone (913) 625-1145

CE/2-NE-NW Sec. 13 Twp. 11 S, Rg. 17
4620 Ft. from South Line of Section
2970 Ft. from East Line of Section

(Note: Locate well on Section Plat on reverse side)

CONTRACTOR: License # NA
Name
City/State

Nearest lease or unit boundary line ... 330 feet
County Ellis
Lease Name Cress-Beach Well # 1

Well Drilled For: Well Class: Type Equipment:
 Oil SWD Infield Mud Rotary
 Gas Inj Pool Ext. Air Rotary
 OWWO Expl Wildcat Cable

Ground surface elevation ... NA feet MSL
Domestic well within 330 feet: ___yes no
Municipal well within one mile: ___yes no

If OWWO: old well info as follows:

Operator
Well Name
Comp Date Old Total Depth

Depth to bottom of fresh water ... 300
Depth to bottom of usable water .. 600-700 est.
Surface pipe by Alternate: 1 2 ___
Surface pipe planned to be set ... 1010
Conductor pipe required ... None
Projected Total Depth ... 3600 feet
Formation ... Arbuckle

I certify that well will comply with K.S.A. 55-101, et seq., plus eventually plugging hole to KCC specifications.

Date 3-14-88 Signature of Operator or Agent Isadore P. Kisner Title Operator

For KCC Use:


Conductor Pipe Required None feet; Minimum Surface Pipe Required 720 feet per Alt. (1) X
* This Authorization Expires 3-25-88 Expires 9-25-88 Approved By R.H. 9-25-88 3-15-88

Must be filed with the K.C.C. five (5) days prior to commencing well
This card void if drilling not started within six (6) months of date received by K.C.C.

Important procedures to follow:

1. Notify District office before setting surface casing.
2. Set surface casing by circulating cement to the top.
3. File completion forms ACO-1 with K.C.C. within 90 days of well completion, following instructions on ACO-1, side 1, and including copies of wireline logs.
4. Notify District office 48 hours prior to old well workover or re-entry.
5. Prior to filing Intent, prepare a proposed plugging plan in case well is D & A, then obtain approval of plan when calling district office prior to setting surface pipe.
6. Submit plugging report (CP-4) to K.C.C. after plugging is completed.
7. Obtain an approved injection docket number before disposing of salt water.
8. Notify K.C.C. within 10 days when injection commences or terminates.
9. If an alternate 2 completion, cement in the production pipe from below any usable water to surface within 120 days of spud date.

**A Regular Section of Land
1 Mile = 5,280 Ft.**

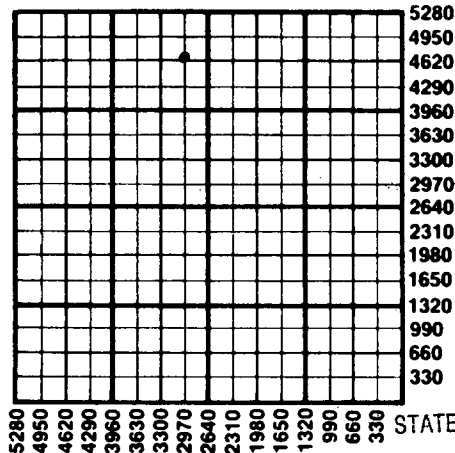

RECEIVED
STATE CORPORATION COMMISSION

MAR 15 1988

03-15-88
CONSERVATION DIVISION
Wichita, Kansas

State Corporation Commission of Kansas
Conservation Division
200 Colorado Derby Building
Wichita, Kansas 67202
(316) 263-3238