

NOTICE OF INTENTION TO DRILL

(see rules on reverse side)

Starting Date December 2, 1985 month day year

API Number 15-179-20,853-0000

OPERATOR: License # 5375 Name Hillenburg Oil Company Address 11600 S. Lynn Lane Road City/State/Zip Broken Arrow OK 74013 Contact Person Harold A. Hillenburg, Jr. Phone 918-455-4444

C... SW... SE... Sec. 10 Twp. 10 S, Rg. 29 East X West 660 Ft. from South Line of Section 1980 Ft. from East Line of Section

(Note: Locate well on Section Plat on reverse side)

CONTRACTOR: License # 5420 Name White & Ellis Drilling City/State Wichita, KS 67202

Nearest lease or unit boundary line 660 feet County Sheridan

Lease Name Stewart Well # 1 Ground surface elevation 2833 feet MSL

Well Drilled For: Well Class: Type Equipment: XX Oil SWD XX Infield XX Mud Rotary Gas Inj Pool Ext Air Rotary OWWO Expl Wildcat Cable

Domestic well within 330 feet: yes X no Municipal well within one mile: yes X no Surface pipe by Alternate: 1 2 X Depth to bottom of fresh water 200 Depth to bottom of usable water 200 ~1500 Surface pipe planned to be set 250 Projected Total Depth 4600 feet Formation Mississippian

If OWWO: old well info as follows:

Operator Well Name Comp Date Old Total Depth

I certify that well will comply with K.S.A. 55-101, et seq., plus eventually plugging hole to KCC specifications.

cementing will be done immediately upon setting production casing.

Date 11-25-85 Signature of Operator or Agent Title Partner

For KCC Use:


Conductor Pipe Required feet; Minimum Surface Pipe Required feet per Alt. 1 2 This Authorization Expires 6-2-80 Approved By Roy 12-2-85

Must be filed with the K.C.C. five (5) days prior to commencing well
 This card void if drilling not started within six (6) months of date received by K.C.C.

Important procedures to follow:

1. Notify District office before setting surface casing.
2. Set surface casing by circulating cement to the top.
3. File completion forms ACO-1 with K.C.C. within 90 days of well completion, following instructions on ACO-1, side 1, and including copies of wireline logs.
4. Notify District office 48 hours prior to old well workover or re-entry.
5. Prior to filing Intent, prepare a proposed plugging plan in case well is D & A, then obtain approval of plan when calling district office prior to setting surface pipe.
6. Submit plugging report (CP-4) to K.C.C. after plugging is completed.
7. Obtain an approved injection docket number before disposing of salt water.
8. Notify K.C.C. within 10 days when injection commences or terminates.
9. If an alternate 2 completion, cement in the production pipe from below any usable water to surface within 120 days of spud date.

A Regular Section of Land
1 Mile = 5,280 Ft.

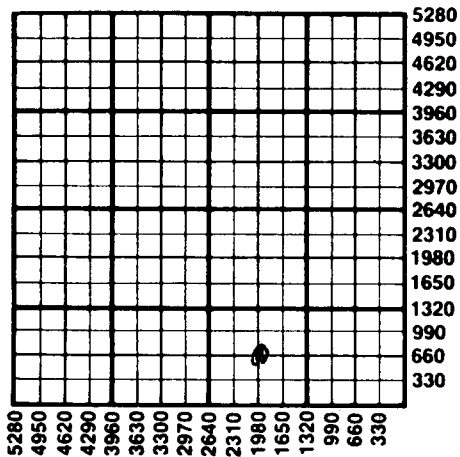

STATE CORPORATION COMMISSION

DEC 2 1985
 12-02-85
 CONSERVATION DIVISION
 Wichita, Kansas

State Corporation Commission of Kansas
 Conservation Division
 200 Colorado Derby Building
 Wichita, Kansas 67202
 (316) 263-3238