


WELL PLUGGING RECORD

Give All Information Completely
Make Required Affidavit
Mail or Deliver Report to:
Conservation Division
State Corporation Commission
800 Bitting Building
Wichita, Kansas

NORTH

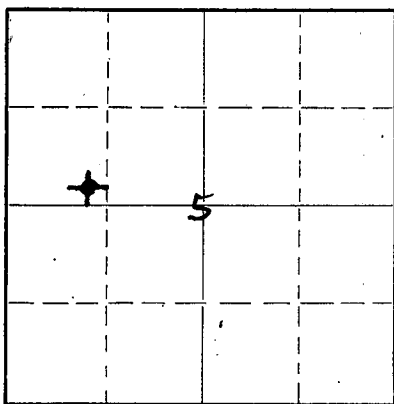

Locate well correctly on above
Section Plat

Russell County. Sec 5 Twp. 13 Rge. (E) 15 (W)
Location as "NE/CNW¹/₄SW¹/₄" or footage from lines SE/4 SW/4 NW/4
Lease Owner GROW and TRACEY
Lease Name TRACEY Well No. I
Office Address Russell, Kansas
Character of Well (completed as Oil, Gas or Dry Hole) OIL
Date well completed June 21st, 1949
Application for plugging filed November 8, 1950 (verbal) 19
Application for plugging approved November 15, 1950 19
Plugging commenced II-9 19 50
Plugging completed II-I4 19 50
Reason for abandonment of well or producing formation DRY

If a producing well is abandoned, date of last production Sept. 1st, 1949
Was permission obtained from the Conservation Division or its agents before plugging was commenced? YES

Name of Conservation Agent who supervised plugging of this well ELDON FETTY
Producing formation Kansas City Lime Depth to top 2994 Bottom 2998 Total Depth of Well 3273 Feet
Show depth and thickness of all water, oil and gas formations.

OIL, GAS OR WATER RECORDS

CASING RECORD

Formation	Content	From	To	Size	Put In	Pulled Out
Kansas City lime	Oil & water	2994	2998	8 5/8"	185'	cemented
Kansas City lime	Oil & water	3015	3023			
Kansas City lime	Oil & gas	3031	3035	5 1/2"	3273'	2596'
Kansas City lime	Oil	3143	3147			
Squeezed 100 sacks cement in perforations at 3015 to 3023						

Describe in detail the manner in which the well was plugged, indicating where the mud fluid was placed and the method or methods used in introducing it into the hole. If cement or other plugs were used, state the character of same and depth placed, from _____ feet to _____ feet for each plug set.

Filled hole with chat to 2985'.
Dumped 4sacks of cement, at 2985', with dump bailor.
Shot off and pulled 2596' of 5 1/2" pipe.
Mudded hole to 185'. Set 10' rock bridge at 185'.
Dumped 15 sacks of cement at 175', with dump bailor.
Mudded to 35'. set 10' rock bridge at 35'.
Dumped 10 sacks of cement, to fill top 25' of hole.

RECEIVED
STATE CORPORATION COMMISSION
01-03-1951
JAN X 3 1951
CONSERVATION DIVISION
Wichita, Kansas

(If additional description is necessary, use BACK of this sheet)

Correspondence regarding this well should be addressed to Grow & Tracey
Address Russell, Kansas

STATE OF Kansas COUNTY OF Sedgewick, ss.

(employee of owner) or (owner or operator) of the above-described well,
being first duly sworn on oath, says: That I have knowledge of the facts, statements, and matters herein contained and the log of the above-described well as filed and that the same are true and correct. So help me God.

(Signature) Grow & Tracey
By Chester Grow
Russell, Kansas
(Address)

SUBSCRIBED AND SWORN to before me this 3'd day of January, 1951.
Edward S. Preuler
Notary Public.

My commission expires _____

PLUGGING
FILE SEC 5 T 13 R 15 W
BOOK PAGE 43 LINE 7

TRACEY #1 - WELL LOG

Stearns Petroleum, Incorporated, et al
 Commenced: 5-27-48
 Completed: 7-31-48

SE SW NW, SECTION 5-13-15W,
 Russell County, Kansas

Casing Record

8-5/8" - 185' Cemented
 5-1/2" - 3272' " "

Russell County
 STATE OF KANSAS

CONS. 01-05-1951

	FROM	TO
Clay and shale	0	40
Shells, shale & limestone	40	185
8-5/8" - 185' cmtd w/85 sacks, Cement circulated.		
Shale	185	360
Iron	360	395
Sand and Iron	395	445
Iron	445	535
Sand and shale	535	884
ANHYDRITE	884	932
Shells and red rock	932	1140
Shale and shells	1140	1405
Shale	1405	1425
Salt	1425	1555
Shale and shells	1555	1605
Lime and shale	1605	1855
Lime	1855	1890
Shale and lime	1890	1955
Shale and shells	1955	2160
Shale and lime	2160	2805
Lime	2805	2865
Shale and lime	2865	3090
Circ 1 hr @ 3254'		
Lime	3090	3273
Circ 1 1/2 hrs @ 3273'		

Straight Hole Tests
 Totco 360 - 1°

906 to 932 Totco - 1°

Totco 1650 - 15 min. off

Totco 1900 - 15 min. off

Totco 2260 - 45 min. off
 " 2600 - 1°

Totco 2900 - 1°

3273 TOTAL DEPTH

ARBUCKLE - 3260'
 5-1/2" OD - 3272', cmtd w/125 sacks.

LANSING - K.C. - 2967'

CONGLOMERATE - 3239'

Perforated 6 shots 3190-94'

" " 3 " 3198-99'

" " 9 " 3194-97'

Gun showed dry cement and some lime, (no oil).

Acidized casing w/1000 gallons @ 3190-99'

Perforated 10 shots 3166 1/2 - 70 1/2'

" " 9 " 3151-54'

" " 12 " 3143-47'

" " 12 " 3015-19'

" " 12 " 3019-23 1/2'

" " 18 " 2881-2885'

" " 12 " 3032-36'

" " 12 " 3038-42'

" " 12 " 2994-98'

STATE OF KANSAS)
) SS
 COUNTY OF RUSSELL)

I hereby certify that the above information is true and correct to the best of my knowledge.

PLUGGING
 FILE SEC 5 T 13 R 54
 ROCK PAGE 13 LINE 7

O. G. STEARNS
 O. G. Stearns

- Subscribed and sworn to before me this 2nd day of September, 1948.

Paul Dalton
 Notary Public

My Commission Expires June 20 1953