


WELL PLUGGING RECORD

Give All Information Completely  
Make Required Affidavit  
Mail or Deliver Report to:  
Conservation Division  
State Corporation Commission  
800 Bitting Building  
Wichita, Kansas

NORTH

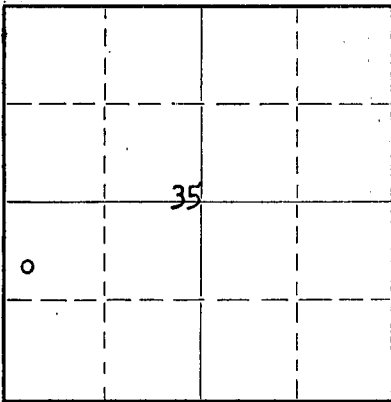

Locate well correctly on above Section Flat

Russell County. Sec. 35 Twp. 13 Rge. 14 (E) W (W)

Location as "NE/CNW $\frac{1}{4}$ SW $\frac{1}{4}$ " or footage from lines SW NW SW  
Lease Owner H. H. Blair Etal  
Lease Name Peter Boxberger Well No. #3  
Office Address 600 Bitting Building, Wichita, Kansas  
Character of Well (completed as Oil, Gas or Dry Hole) Dry Hole  
Date well completed August 9, 1949  
Application for plugging filed August 9, 1949  
Application for plugging approved August 16, 1949  
Plugging commenced August 9, 1949  
Plugging completed August 9, 1949  
Reason for abandonment of well or producing formation Dry Hole

If a producing well is abandoned, date of last production 19  
Was permission obtained from the Conservation Division or its agents before plugging was commenced? Yes

Name of Conservation Agent who supervised plugging of this well Mr. C. D. Stough, Great Bend, Kansas  
Producing formation Depth to top Bottom Total Depth of Well 3322 Feet  
Show depth and thickness of all water, oil and gas formations.

OIL, GAS OR WATER RECORDS

CASING RECORD

Formation	Content	From	To	Size	Put In	Pulled Out
Topeka		2642	2943	10"	123'	
Lansing		2997	3207			
Kansas City		3207	3294			
Arbuckle		3294	3312			
Reagan		3312	3322			

Describe in detail the manner in which the well was plugged, indicating where the mud fluid was placed and the method or methods used in introducing it into the hole. If cement or other plugs were used, state the character of same and depth placed, from feet to feet for each plug set.

Bottom of hole cemented with 40 sacks cement. Hole filled with mud to 123'. Wood plug set at 122', filled to surface with 40 sacks cement.

RECEIVED  
AUG 26 1949  
STATE COMMISSION  
KANSAS

(If additional description is necessary, use BACK of this sheet)

Correspondence regarding this well should be addressed to H. H. Blair  
Address 600 Bitting Building, Wichita 2, Kansas

STATE OF Kansas, COUNTY OF Sedgwick, ss.  
Louis E. Potucek (employee of owner) or (owner or operator) of the above-described well,

being first duly sworn on oath, says: That I have knowledge of the facts, statements, and matters herein contained and the log of the above-described well as filed and that the same are true and correct. So help me God.

(Signature) Louis E. Potucek

(Address)

SUBSCRIBED AND SWORN to before me this 25th day of August, 1949.

Jay J. Wilson  
Notary Public.

My commission expires July 3, 1950.

22-5133-s 9-48-10M

PLUGGING  
FILE SEC. 35 T. 13 R. 14  
PAGE 109 LINE 36

PETER BOXBERGER - WELL LOG  
#3

OWNED BY: H. H. BLAIR ET AL  
COMMENCED: 7/26/49  
COMPLETED: 8/9/49

LOCATION: SW NW SW  
35-13S-11W  
Russell County, Kansas

PRODUCTION: D & A

ELEVATION: 1837 Derrick Floor  
1840 Rotary Bushing

CASING RECORD:

Cemented 123' of 10" Surface  
Casing with 50 Sacks Bulk Cement

Surface Clay	123
Shale and Shells	210
Red Bed	225
Shale and Shells	335
Sand and Pyrite	355
Shale and Sand	382
Shale and Shells	720
Shale, Shells and Sand	795
Shale and Red Bed	842
Anhydrite	880
Shale and Shells	1295
Salt and Shale	1470
Shale and Shells	1600
Lime and Shale	1700
Shale and Shells	1775
Lime and Shale	1798
Lime	1865
Lime and Shale	2030
Shale	2075
Shale and Shells	2245
Shale	2330
Shale and Shells	2542
Shale	2645
Lime and Shale	2770
Shale and Lime	2820
Lime and Shale	2908
Shale and Lime	2955
Lime and Shale	3048
Lime	3160
Shale and Lime	3175
Lime	3246
Shale and Lime	3280
Lime	3294
Arbuckle	3320
Lime - Arbuckle	3322
Total Rotary Depth	3322

RECORDED  
INDEXED  
AUG 26 1949  
08-26-1949  
STATE CORPORATION  
COMMISSION  
KANSAS

