


WELL PLUGGING RECORD

Give All Information Completely
Make Required Affidavit
Mail or Deliver Report to:
Conservation Division
State Corporation Commission
800 Bittling Building
Wichita, Kansas

NORTH

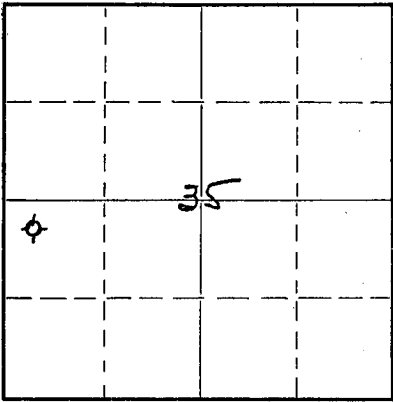

Locate well correctly on above Section Plat

Russell County, Sec. 35 Twp. 13 Rge. 14 (E) (W)
Location as "NE/CNW $\frac{1}{4}$ SW $\frac{1}{4}$ " or footage from lines NW-NW-SW
Lease Owner H.H. Blair Dvl. Co.
Lease Name Pete Box Berger Well No. #2
Office Address Bx 113 Russell Kansas
Character of Well (completed as Oil, Gas or Dry Hole) Dry Hole
Date well completed June 6, 19 49
Application for plugging filed September 1, 19 49
Application for plugging approved September 6, 19 49
Plugging commenced 8/25/ 19 49
Plugging completed 9/2/ 19 49
Reason for abandonment of well or producing formation Dry Hole

If a producing well is abandoned, date of last production _____ 19____
Was permission obtained from the Conservation Division or its agents before plugging was commenced? Yes - MR. Petty Hays Kansas

Name of Conservation Agent who supervised plugging of this well MR. Petty
Producing formation _____ Depth to top _____ Bottom _____ Total Depth of Well 3292 Feet
Show depth and thickness of all water, oil and gas formations.

OIL, GAS OR WATER RECORDS

CASING RECORD

Formation	Content	From	To	Size	Put In	Pulled Out
				8 5/8"	129'	None
				5 1/2"	3289'	2766'-6"

Describe in detail the manner in which the well was plugged, indicating where the mud fluid was placed and the method or methods used in introducing it into the hole. If cement or other plugs were used, state the character of same and depth placed, from _____ feet to _____ feet for each plug set.

Bottom plug @ 3012' - dumped 5 sax - top of plug @ 2864'
Mudded Hole By Dump Method To 129'
SET ROCK BRIDGE @ 129' And dumped 15 sax - top of plug @ 129'
Mudded Hole To 35' By dump Method
Dumped 10 Sax @ 35' Top of plug in cellar

SEP 10 1949
STATE CORPORATION COMMISSION
KANSAS

General Oil Tool Co.
By: Charles C. Prater Jr.

Well Plugged O.K.
Charles C. Prater Jr.

(If additional description is necessary, use BACK of this sheet)
Correspondence regarding this well should be addressed to _____
Address 600 Bittling Bldg. Wichita Kansas

STATE OF Kansas COUNTY OF Sedgwick, ss. _____
Glen Harley (employee of owner) or (owner or operator) of the above-described well,
being first duly sworn on oath, says: That I have knowledge of the facts, statements, and matters herein contained and the log of the above-described well as filed and that the same are true and correct. So help me God.

(Signature) _____

(Address) _____

SUBSCRIBED AND SWORN to before me this 9th day of September, 19 49.

Jay I. Wilson
Notary Public.

My commission expires July 3, 1950.

22-5133-5 9-48-10M
PLUGGING
FILE SEC 35T13R14W
BOOK PAGE 118 LINE 41

15-167-19367-00-00

PETER BOXBERGER #2 - WELL LOG

OWNED BY: H. H. BLAIR Et al
COMMENCED: 4/29/49
COMPLETED: 5/14/49

LOCATION: NW NW SW
35-13S-14W
Russell County, Ks

ELEVATION: 1837 D.F.

CASING RECORD:

129' of 8 5/8" Surface Pipe
Cemented same with 75 Sacks Cement
Set 5 1/2" OD. Casing at 3289'
Cemented same with 100 Sacks Cement

Surface Clay and Shale	40
Shale and Shells	255
Red Bed	335
Shale Shells	480
Iron	495
Shale and Shells	845
Anhydrite	880
Shale and Shells	1350
Salt, Shale and Shells	1460
Shale and Shells	1595
Lime	1640
Shale and Lime	1685
Lime and Shale	1865
Lime	1910
Lime and Shale	2008
Shale and Lime shells	2174
Shale and Lime	2343
Shale	2485
Shale and Shells	2540
Shale	2734
Shale and Lime	2811
Lime	2960
Lime and Shale	3011
Lime	3292
Total Depth - Rotary	3292

PLUGGING
 FILE SEC 35 T 13 R 4 W
 BOOK PAGE 12 LINE 41

09-10-1949