


WELL PLUGGING RECORD

Give All Information Completely
Make Required Affidavit
Mail or Deliver Report to:
Conservation Division
State Corporation Commission
211 No. Broadway
Wichita, Kansas

NORTH

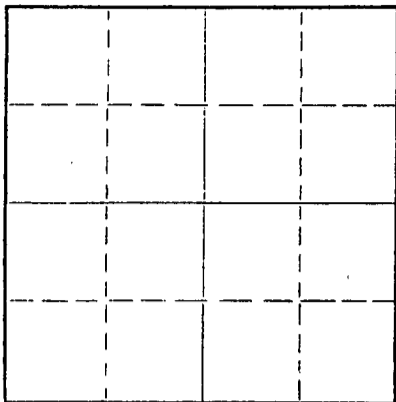

Locate well correctly on above
Section Plat

Ellis County. Sec. 9 Twp. 11S Rge. 17 (X) (W)

Location as "NE/CNW/SW" or footage from lines NW SE NW
Lease Owner Bankoff & Leben
Lease Name Carmichael Well No. 1
Office Address 905 Central Bldg., Wichita, Kansas
Character of Well (completed as Oil, Gas or Dry Hole) Dry Hole
Date well completed August 3, 1957 19
Application for plugging filed August 3, 1957 19
Application for plugging approved August 3, 1957 19
Plugging commenced August 3, 1957 19
Plugging completed August 3, 1957 19
Reason for abandonment of well or producing formation Dry Hole

If a producing well is abandoned, date of last production _____ 19____
Was permission obtained from the Conservation Division or its agents before plugging was commenced? Yes

Name of Conservation Agent who supervised plugging of this well Eldon Petty
Producing formation _____ Depth to top _____ Bottom _____ Total Depth of Well 3502 Feet
Show depth and thickness of all water, oil and gas formations.

OIL, GAS OR WATER RECORDS


CASING RECORD

FORMATION	CONTENT	FROM	TO	SIZE	PUT IN	PULLED OUT
				8 5/8"	221'	

Describe in detail the manner in which the well was plugged, indicating where the mud fluid was placed and the method or methods used in introducing it into the hole. If cement or other plugs were used, state the character of same and depth placed, from _____ feet to _____ feet for each plug set.

1st Plug @ 500' with 25 sacks cement.
2nd Plug @ 300' with 25 sacks cement.
Top Plug @ 40' with 10 sacks cement.

08-10-57

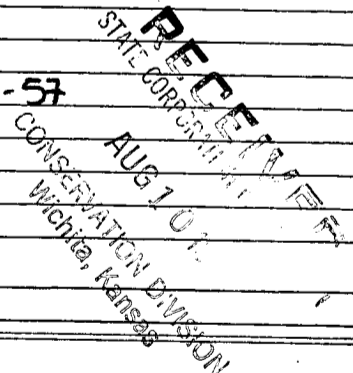

(If additional description is necessary, use BACK of this sheet)
Name of Plugging Contractor Leben Drilling, Inc.
Address 905 Central Building, Wichita, Kansas

STATE OF Kansas, COUNTY OF Sedgwick, ss.
Frank Hamlin (employee of owner) or ~~(owner)~~ of the above-described well, being first duly sworn on oath, says: That I have knowledge of the facts, statements, and matters herein contained and the log of the above-described well as filed and that the same are true and correct. So help me God.

(Signature) Frank Hamlin
905 Central Bldg., Wichita, Kansas
(Address)

SUBSCRIBED AND SWORN TO before me this 5th day of August, 19 57.

My commission expires June 16, 1961.
Ruth N. Benjamin Notary Public.

PLUGGING
FILE SEC 9 T 11 R 17W
BOOK PAGE 34 LINE 20

CONTRACTOR'S WELL LOG

COMPANY:
 CONTRACTOR:
 FARM:
 LOCATION:
 COMMENCED:
 COMPLETED:

BANKOFF-LEBEN DRILLING INC.
 LEBEN DRILLING INC.
 CARMICHAEL NO 1
 NW SE NW SEC. 9 11S 17W
 ELLIS COUNTY, KANSAS
 7-24-57
 8-2-57

0	330	Shale & Shells	<u>TOPS</u>
330	430	Shale Sand & Shells	
430	460	Sand	Lansing 3077 (-1214)
460	555	Shale & Sand	Arbuckle -3442
555	565	Pyrite	
565	770	Shale & Shells	
770	1058	Shale & Red Bed	
1058	1110	Red Bed	
1110	1145	Anhydrite	
1145	1550	Shale & Shells	
1550	1790	Shale & Lime	
1790	2155	Lime & Shale	
2155	3050	Shale & Lime	
3050	3115	Lime & Shale	
3115	3420	Lime	
3420	3460	Conglomerate	
3460	3495	Lime & Chert	
3495	3502	Cherty Lime	
	<u>3502</u>	<u>ROTARY TOTAL DEPTH D & A</u>	

Set 8 5/8" surface casing @ 221' with 100 sacks cement and 2 % CaCl.

I, Frank Hamlin, do hereby certify that the above and foregoing is a true and correct copy of the log of the Carmichael # 1, NW SE NW of Section 9, Township 11 South, Range 17 West, Ellis County, Kansas, as reflected by the files of Leben Drilling, Inc.

LEBEN DRILLING, INC.

BY: Frank Hamlin
 Frank Hamlin

STATE OF KANSAS)ss.
 COUNTY OF SEDGWICK)

Subscribed and sworn to before me, a Notary Public, in and for Sedgwick County, Kansas, this 8th day of August, 1957.

Ruth H. Benjamin
 Ruth H. Benjamin - Notary Public

My Commission expires June 17, 1961.

PLUGGING
 FILE SEC. 9 T. 11 R. 17W
 BOOK PAGE 34 LINE 20

RECEIVED
 STATE CORPORATION COMMISSION
 AUG 8 1957
 WICHITA, KANSAS