


STATE OF KANSAS
STATE CORPORATION COMMISSION

WELL PLUGGING RECORD

Give All Information Completely
Make Required Affidavit
Mail or Deliver Report to:
Conservation Division
State Corporation Commission
211 No. Broadway
Wichita, Kansas

Ellis County. Sec. 9 Twp. 11S Rge. 17W (E) (W)
Location as "NE/CNW%SW%" or footage from lines NE NW NE
Lease Owner Burch Drilling Co., Inc.
Lease Name McCarter Well No. 1
Office Address 1011 Union Center Building, Wichita, Kansas
Character of Well (completed as Oil, Gas or Dry Hole) Dry
Date well completed 7-8-58 19
Application for plugging filed 7-8-58 19
Application for plugging approved 7-8-58 19
Plugging commenced 7-8-58 19
Plugging completed 7-8-58 19
Reason for abandonment of well or producing formation Dry

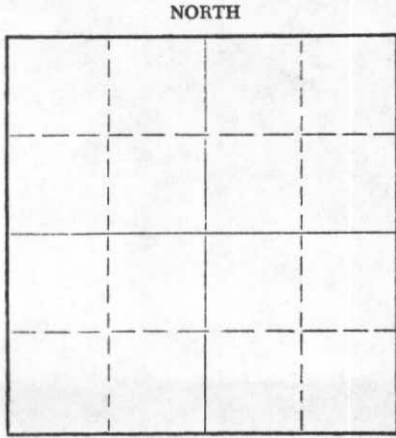

Locate well correctly on above
Section Plat

If a producing well is abandoned, date of last production _____ 19____
Was permission obtained from the Conservation Division or its agents before plugging was com-
menced? yes

Name of Conservation Agent who supervised plugging of this well Eldon Petty
Producing formation _____ Depth to top _____ Bottom _____ Total Depth of Well 3461 Feet
Show depth and thickness of all water, oil and gas formations.

OIL, GAS OR WATER RECORDS

CASING RECORD

| FORMATION | CONTENT | FROM | TO | SIZE | PUT IN | PULLED OUT |
|-----------|---------|------|----|--------|--------|------------|
| | | | | 8 5/8" | 180' | none |
| | | | | | | |
| | | | | | | |
| | | | | | | |
| | | | | | | |
| | | | | | | |
| | | | | | | |
| | | | | | | |
| | | | | | | |

Describe in detail the manner in which the well was plugged, indicating where the mud fluid was placed and the method or methods used in introducing it into the hole. If cement or other plugs were used, state the character of same and depth placed, from _____ feet to _____ feet for each plug set.

Set 1st plug @ 600' w/25 sx.
Set 2nd plug @ 180' w/15 sx.
Set 3rd plug @ 40' w/10 sx.

RECEIVED
STATE CORPORATION COMMISSION
JUL 23 1958 07-23-58
CONSERVATION DIVISION
Wichita, Kansas

(If additional description is necessary, use BACK of this sheet)

Name of Plugging Contractor Burch Drilling Co., Inc.
Address 1011 Union Center, Wichita, Kansas

STATE OF Kansas, COUNTY OF Sedgwick, ss.
Earl M. Burch (~~employee of owner~~) or (owner or operator) of the above-described well, being first duly sworn on oath, says: That I have knowledge of the facts, statements, and matters herein contained and the log of the above-described well as filed and that the same are true and correct. So help me God.

(Signature) Earl M Burch
(Address) _____

SUBSCRIBED AND SWORN TO before me this 14th day of July, 19 58
My commission expires July 27, 1960
Henry Harris Notary Public.



PLUGGING
FILE SEC 9 T 11 R 17W
BOOK PAGE 116 LINE 18

WELL LOG

Burch Drilling Company, Inc.
1 McCarter
NE NW NE 9-11S-17W
Ellis County, Kansas

8 5/8" set @ 180' w/125 sx.
Elevation: 1865 Kelley Bushing
Comm.: 7-1-58
Comp.: 7-8-58
D & A

Tops:

180 Sand & Shale
530 Shale & Shells
930 Shale, Lime & Iron
3083 Shale & Lime
3461 Lime

3461 RTD

Heebner 3036'
Toronto 3057
Lansing 3777
BKC 3332
Marmaton 3358
Conglomerate 3428

DST. # 1 3102-3128 1 hr. Rec. 75' Mud
IBHP 1025#, FBHP 825#.

DST. # 2 3387-3418 1 hr. Rec. 26'
Mud. IBHP 900#, FBHP 690#.

STATE OF KANSAS, COUNTY OF SEDGWICK:

I, Earl M. Burch, President of Burch drilling Co., Inc. being duly sworn on oath, state: That I have knowledge of the facts, statements and matters herein contained and that the same are true and correct.

Earl M. Burch

Subscribed and sworn to before me this 14th day of July, 1958.

Siary Harrison
Notary Public

My Commission expires: July 27, 1960



RECEIVED
STATE CORPORATIONS COMMISSION
JUL 23 1958
CONSERVATION DIVISION
Wichita, Kansas

PLUGGING
FILE SEC 9 T 11 R 17W
BOOK PAGE 116 LINE 18