

STATE OF KANSAS
STATE CORPORATION COMMISSION

WELL PLUGGING RECORD

Give All Information Completely
Make Required Affidavit
Mail or Deliver Report to
Conservation Division
State Corporation Comm.
245 North Water
Wichita, KS 67202

Russell County. Sec. 15 Twp. 13S Rge. 15 ~~NE~~W
Location as "NE/CNW 1/4 SW 1/4" or footage from lines
SE NE SW

Lease Owner Isern-Schultz O&G
Lease Name Brungardt Well No. 1
Office Address Box 486 Ellinwood, Kansas 67526
Character of Well (Completed as Oil, Gas or Dry Hole)

Dry Hole

Date Well completed June 19 19 81
Application for plugging filed June 19 19 81
Application for plugging approved June 19 19 81
Plugging commenced June 19 19 81
Plugging completed June 19 19 81


Reason for abandonment of well or producing formation

Dry Hole

If a producing well is abandoned, date of last production 19

Was permission obtained from the Conservation Division or its agents before plugging was commenced? Yes

Name of Conservation Agent who supervised plugging of this well Marion Schmidt
Producing formation Depth to top Bottom Total Depth of Well 3330'
Show depth and thickness of all water, oil and gas formations.

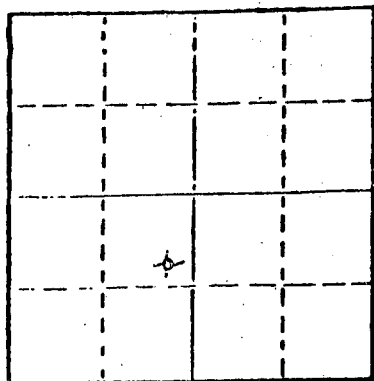

Locate well correctly on above Section Plot

OIL, GAS OR WATER RECORDS

CASING RECORD

FORMATION	CONTENT	FROM	TO	SIZE	PUT IN	PULLED OUT
Surface		0	206'	8 5/8"	206'	0

Describe in detail the manner in which the well was plugged, indicating where the mud fluid was placed and the method or methods used in introducing it into the hold. If cement or other plugs were used, state the character of same and depth placed, from feet to feet for each plug set.

1st Plug set at 620' with 50 sacks common cement 50-50 poz 3% Cal Cl 4% Gel

2nd Plug set at 225' with 30 sacks common cement 50-50 poz 3% Cal Cl 4% Gel

3rd Plug set at 40' with 10 sacks common cement 50-50 poz 3% Cal Cl 4% Gel

10 sacks in rathole

Heavy drilling mud between each plug

(If additional description is necessary, use BACK of this sheet)

Name of Plugging Contractor Sun Oilwell Cementing

RECEIVED

STATE CORPORATION COMMISSION

07-06-1981
III - 6 1981

STATE OF Kansas COUNTY OF Graham CONSERVATION DIVISION
Wichita, Kansas
Jerry M. Helberg (employee of owner) or (owner or operator)
of the above-described well, being first duly sworn on oath, says: That I have knowledge of the facts, statements, and matters herein contained and the log of the above-described well as filed and that the same are true and correct. So help me God.

(Signature)


Box 32 Morland, Kansas 67650
(Address)

SUBSCRIBED AND SWORN TO before me this 30 day of June, 19 81

Notary Public.

My commission expires

12-4-83

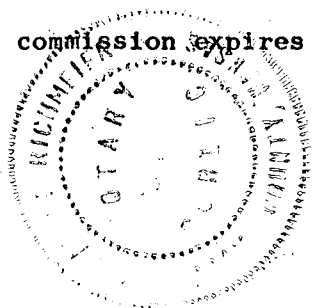

DRILLERS LOG

BRUNGARDT #1

CASING RECORD:

8 5/8" set at 206'

TOTAL DEPTH:

3330'

DESCRIPTION:

Sec. 15, Twp. 13S, Rge. 15W

SE NE SW

OPERATOR: Isern-Schultz O&G

CONTRACTOR: Helberg Oil Company

COMMENCED: June 11, 1981

COMPLETED: June 19, 1981

FORMATION	TO	FROM	REMARKS
Sand	0	225	
Sand and Shale	225	884	
Anhydrite	884	1134	
Shale	1134	1628	
Shale and Lime	1628	1821	
Lime and Shale	1821	2000	
Lime and Shale	2000	2132	
Lime and Shale	2132	2305	
Shale	2305	2437	
Lime and Shale	2437	2600	
Lime and Shale	2600	2740	
Shale	2740	2865	
Shale	2865	2970	
Lime	2970	3060	
Lime	3060	3110	
Lime	3110	3148	
Lime	3148	3207	
Lime	3207	3258	
Lime and Shale	3258	3313	
Shale	3313	3330	
T.D.	3330		D&A

I certify that the above is a true and correct copy of the log to the best of my knowledge.

Helberg Oil Company

Jerry M. Helberg
 Jerry M. Helberg

Subscribed and sworn to before me this 30 day of June, 1981.

James Reisman
 Notary Public

My commission expires 12-4-85

RECEIVED
 STATE CONSERVATION COMMISSION

JUN 29 1981
 07-06-1981
 CONSERVATION DIVISION
 Wichita, Kansas

