

15-167-00474-00-00

STATE OF KANSAS
STATE CORPORATION COMMISSION

WELL PLUGGING RECORD


OR

FORMATION PLUGGING RECORD

Strike out upper line when reporting plugging of formations.

Give All Information Completely
Make Required Affidavit
Mail or Deliver Report to:
Conservation Division
State Corporation Commission
800 Bitting Building
Wichita, Kansas

NORTH

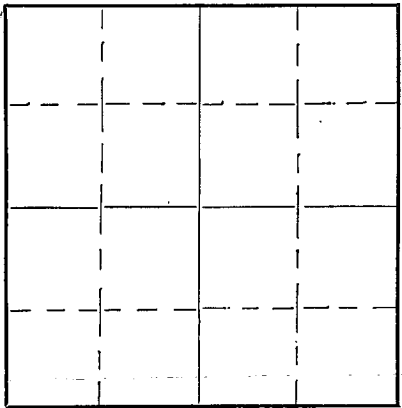

Locate well correctly on above Section Plat

Russell County. Sec. 17 Twp. 13 Rge. 15 (E) W (W)
Location as "NE 1/4 NW 1/4 SW 1/4" or footage from lines N 1/2 NE SW
Lease Owner. ~~Schmidt~~ Earl F. Wakefield
Lease Name. Schmidtberger Well No. 1
Office Address. 307-8 Union National Bank Bldg.,
Character of Well (completed as Oil, Gas or Dry Hole) dry hole
Date, well completed. 2/23/40 193
Application for plugging filed. 2/22/40 193
Application for plugging approved. 2/23/40 193
Plugging Commenced. 2/23/40 193
Plugging Completed. 2/24/40 193
Reason for abandonment of well or producing formation.

If a producing well is abandoned, date of last production. 193
Was permission obtained from the Conservation Division or its agents before plugging was commenced? yes

Name of Conservation Agent who supervised plugging of this well. C. T. Alexander.
Producing formation. Depth to top. Bottom. Total Depth of Well. 3355 Feet
Show depth and thickness of all water, oil and gas formations.


OIL, GAS OR WATER RECORDS

CASING RECORD

Formation	Content	From	To	Size	Put In	Pulled Out
				15 1/2"	285	all
				12 1/2"	530	all
				10"	975	all
				8"	2535	all
				6 5/8"	3050	all
				U.R.	3089	

Describe in detail the manner in which the well was plugged, indicating where the mud fluid was placed and the method or methods used in introducing it into the hole. If cement or other plugs were used, state the character of same and depth placed, from feet to feet for each plug set.

Mud from 3355 to 3310 and ~~then~~ cement to 3295. Filled with mud to 3091 and cemented to 3076. Filled with mud to 2788 and cemented to 2773 then filled with mud to 245 and hole bridged at 245 and a 15' cement plug set on bridge. then mud to bottom of cellar and capped at top with cement.

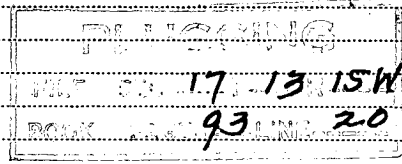

(If additional description is necessary, use BACK of this sheet)

Correspondence regarding this well should be addressed to Earl F. Wakefield, 307-8 Union National Bank Bldg., Wichita, Kansas.

STATE OF Kansas, COUNTY OF Sedgwick, ss.
Earl F. Wakefield (employee of owner) or (owner or operator) of the above-described well, being first duly sworn on oath, says: That I have knowledge of the facts, statements, and matters herein contained and the log of the above-described well as filed and that the same are true and correct. So help me God.

(Signature) Earl F. Wakefield

(Address)

SUBSCRIBED AND SWORN to before me this 7th day of March, 1940.

My commission expires Jan. 15, 1942.

Notary Public. (Signature)

SCHMITBERGER NO.

HW-13-15 Russell County, Kansas

Location	-	C/N ¹ / ₂ NE ¹ / ₄ SW ¹ / ₄	<u>Casing Record</u>		
Lease Owner	-	Earl F. Wakefield			
Contractor	-	Earl F. Wakefield	15 ¹ / ₂ "	285	8 ¹ / ₂ " 2535
Commenced	-	1/15/40	12 ³ / ₈ "	530	6-5/8" 3050
Completed	-	2/23/40	10"	975	U.R. 3089
Total Depth	-	3355'			

Cellar	9	Lime	2040	Lime	3038
Yellow Clay	20	Shale Red	2055	Shale Red	3040
Shale Dark	195	Lime	2065	Shale	3050
Shale Light Sdy	200	Shale	2073	Run 6-5/8" Pipe	3050
Shale Light	215	Lime, Shells		Lime	3076
1/2 BWH 195 to	200	and Shale	2090	Correction -	
Shale Light	230	Lime	2095	Halliburton's	
Shale Brown	280	Shale	2100	Measurements -	
Sand	305	Lime	2160	3076 equals	3074
HFV 285 to	305	Shale Red	2190	2 BWH at 3055 -	3060
Run 15 ¹ / ₂ " Pipe	285	Lime Soft Brkn	2200	Shale Break	3081
Shale	320	1/3 BWH 2190 -	2200	Lime Soft	3084
Sand	345	Lime	2235	2 BWH 3081 to	3084
Shale Pink	380	Shale Blue	2260	Lime Hard	3123
HFV 325 to	340	Lime	2270	Shale	3125
Shale Dark	430	Shale Blue	2275	Lime	3144
Sand	445	Lime	2300	1/2 BWH	3140
Shale Dark	485	Lime Broken	2320	Lime Soft Brkn	3147
Lime	488	Shale Blue	2360	Lime Hard	3160
Shale Dark	515	Lime	2385	Lime	3165
515 equals	523	Shale Blue	2418	Shale	3167
Shale Dark	530	Lime	2420	Lime	3185
Run 12 ¹ / ₂ " Pipe	530	Hole Caving	2420	Shale	3191
Sand	580	Lime	2430	Lime	3202
Sandy Shale	680	Shale Blue	2458	Shale Break	3205
Sandy Shale	805	Lime 2470	2470	Lime Shell	3208
Sandy Shale Red	940	Shale & Shells	2490	Shale Blue	3212
Chalk	943	Lime	2493	Lime	3215
Lime	975	Shale	2510	Lime	3224
Run 10" Pipe	975	Shale Dark	2530	Shale	3227
Lime	982	Lime	2538	Lime	3246
Red Rock	1125	1-1/2 BWH	2515	Red Rock	3248
Shale Blue	1135	Run 8 ¹ / ₄ " Pipe	2535	Lime	3250
Shale Blue	1150	Lime	2550	Shale Blue	3262
Red Rock	1225	Shale Blue	2560	Lime	3278
Shale Blue	1305	Lime	2565	Shale	3284
Shale & Salt	1360	Shale & Shale Blue	2590	Lime	3293
Salt	1580	Lime	2605	Shale	3297
Lime	1585	Shale Blue	2610	Lime	3300
Shale Blue	1620	Lime	2615	Shale Red	3310
Lime Broken	1660	Shale	2630	Reducing Hole	3310
Lime	1690	Lime	2640	Arbuckle	
Shale Red	1695	Shale	2660	Dolomite	3355
Lime	1720	Lime	2670	Water	3355
Lime Broken	1725	Shale	2685		
Shale Red	1730	Lime	2690	TOTAL DEPTH	3355
Shale Red	1740	Shale	2703		
Lime	1770	Lime	2745		
Shale Brown	1780	Shale Blue	2750		
Lime	1825	Lime	2768		
Shale Red	1850	Shale	2788		
Lime Broken	1880	Lime	2850		
Shale Blue	1890	Lime	2910		
Lime	1960	Shale	2915		
Shale Light	1970	Lime	2970		
Shale Red	1980	Lime Broken	2975		
Lime	2000	1 BWH	2975		
Shale Brown	2010	Lime	2980		



PLUGGING
 FILE 351-12-13-15W
 BOOK PAGE 93 LINE 20