

15167-02076-00-00

FORM CP-4


STATE OF KANSAS
STATE CORPORATION COMMISSION
CONSERVATION DIVISION
P. O. BOX 17027
WICHITA, KANSAS 67217

WELL PLUGGING RECORD

Russell County. Sec. 17 Twp. 13 Rge. 15 (E) (W) X

Location as "NE/CNW/SE/SW" or footage from lines NW SE SW
Lease Owner A. F. Schmidt Oil Operators
Lease Name McKune Well No. #3
Office Address Box 662 Russell, Kansas
Character of Well (completed as Oil, Gas or Dry Hole)
Date well completed 19
Application for plugging filed 19
Application for plugging approved 19
Plugging commenced 7-22-74 19
Plugging completed 10-16-74 19
Reason for abandonment of well or producing formation

NORTH

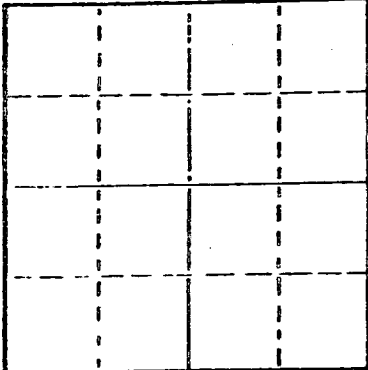

Locate well correctly on above Section Plat

If a producing well is abandoned, date of last production 19
Was permission obtained from the Conservation Division or its agents before plugging was commenced?

Name of Conservation Agent who supervised plugging of this well Donald Truan
Producing formation Depth to top Bottom Total Depth of Well 3297' Feet
Show depth and thickness of all water, oil and gas formations.

OIL, GAS OR WATER RECORDS

CASING RECORD

FORMATION	CONTENT	FROM	TO	SIZE	FOOT IN	PULLED OUT
	RECEIVED STATE CORPORATION COMMISSION OCT 2 1974 CONSERVATION DIVISION Wichita, Kansas			5 1/2"	3296'	2780.44'
				8 5/8"	591'	

Describe in detail the manner in which the well was plugged, indicating where the mud fluid was placed and the method or methods used in introducing it into the hole. If cement or other plugs were used, state the character of same and depth placed, from feet to feet for each plug set.

Made bottom hole plug back with sand to 3000'. Mixed and ran 5 sacks cement thru dump bailer.
Squeezed hole with 3 sacks bulls, 20 sacks gel, Released plug and displaced with 100 sacks 50/50 pozmix with 4% gel.

(If additional description is necessary, use BACK of this sheet)
Name of Plugging Contractor Southwest Casing Pulling Co.
Address Box 364 Great Bend, Kansas


RECEIVED
STATE CORPORATION COMMISSION
OCT 18 1974
CONSERVATION DIVISION
Wichita, Kansas

STATE OF Kansas COUNTY OF Barton ss.
Southwest Casing Pulling Co. (employee of owner) or (owner or operator) of the above-described well, being first duly sworn on oath, says: That I have knowledge of the facts, statements, and matters herein contained and the log of the above-described well as filed and that the same are true and correct. So help me God.

(Signature) W. C. Spencer Sec.
Box 364 Great Bend, Kansas (Address)

Subscribed and sworn to before me this 17 day of October 1974

Sidney D. Miller
Notary Public.

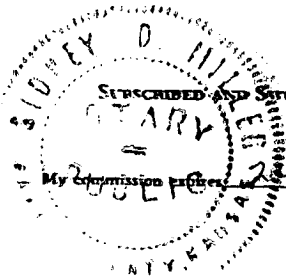

WELL LOG

COMPANY A. F. Schmidt Operations
 CONTRACTOR Triangle Drilling, Inc.
 FARM #3 McKune
 LOCATION NW SE SW of section 17-13-15W
 Russell County, Kansas
 ELEVATION 1871 KB
 SURFACE PIPE 8 5/8" cemented @ 591' w/300 sx pozmix
 PRODUCTION STRING 5 1/2" " " 3296' w/100 sx latex cement
 COMMENCED July 7, 1958
 COMPLETED July 19, 1958

RECEIVED
 STATE CORPORATION COMMISSION
 06-17-1974
 JUN 17 1974
 CONSERVATION DIVISION
 Wichita, Kansas

<u>FORMATION</u>	<u>DEPTH TO BOTTOM OF FORMATION</u>
Surface clay and post rock	15
Post rock and hard sand	50
Hard sandstone and shale	220
Shale and shells	340
Hard sandstone and pyrite	351
Shale and shells	450
Shale and dry sandstone streaks	505
Sandstone	571
Red bed	928
Anhydrite	968
Shale and shells	1555
Limestone and shale	1760
Broken limestone and shale streaks	1855
Limestone	1920
Broken limestone and sandstone	1995
Sandy limestone	2050
Limestone and shale	2762
Limestone	3259
Limestone and shale	3295
Dolomite	3296 1/2

FORMATION TOPS

Anhydrite	928 (+ 943)
Topeka	2763 (- 892)
Heebner	2982 (-1111)
Toronto	3001 (-1130)
Lansing	3029 (-1158)
Base K. C.	3259 (-1388)
Arbuckle	3295 (-1424)
RTD	3296 1/2 (-1425 1/2)

A F F I D A V I T

STATE OF KANSAS, COUNTY OF BARTON, SS.

I, Donald D. Vaughan, of the TRIANGLE DRILLING, INC., being first duly sworn on oath, state; That I have knowledge of the facts, statements and matters herein contained and that the same are true and correct.

Subscribed and sworn before me this Donald D. Vaughan
 24th. day of July, 1958 Dean E. Cooley MY commission expires April 29, 1961