

15167-05004-00-00



STATE OF KANSAS
STATE CORPORATION COMMISSION


Form CP-4

Give All Information Completely
Make Required Affidavit
Mail or Deliver Report to:
Conservation Division
State Corporation Commission
211 No. Broadway
Wichita, Kansas

WELL PLUGGING RECORD

Russell County. Sec. 22 Twp. 13 Rge. 15W (E) (W)
Location as "NE/CNW*SW*" or footage from lines. SE SW SE
Lease Owner Barton Brothers Oil Co.
Lease Name Mai Well No. 1
Office Address 501 East Fifth St. Russell, Kansas 67665
Character of Well (completed as Oil, Gas or Dry Hole) Dry Hole
Date well completed July 21, 1964
Application for plugging filed July 21, 1964
Application for plugging approved July 21, 1964
Plugging commenced July 21, 1964
Plugging completed July 21, 1964
Reason for abandonment of well or producing formation Dry

NORTH

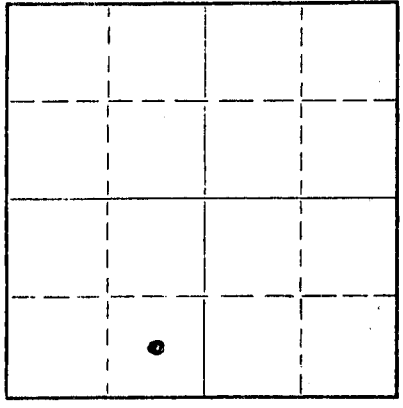

Locate well correctly on above Section Plat

If a producing well is abandoned, date of last production _____ 19____
Was permission obtained from the Conservation Division or its agents before plugging was commenced? Yes

Name of Conservation Agent who supervised plugging of this well Donald Truan
Producing formation _____ Depth to top _____ Bottom _____ Total Depth of Well 3339 Feet
Show depth and thickness of all water, oil and gas formations.

OIL, GAS OR WATER RECORDS

CASING RECORD

FORMATION	CONTENT	FROM	TO	SIZE	PUT IN	PULLED OUT
		0	265	8 5/8	265	0

Describe in detail the manner in which the well was plugged, indicating where the mud fluid was placed and the method or methods used in introducing it into the hole. If cement or other plugs were used, state the character of same and depth placed, from _____ feet to _____ feet for each plug set.

Mud to 250' Plug and 25 sacks cement through drill pipe. Mud to 40' two sacks hulls and 10 sacks cement. Completed at 1:30 A. M.

RECEIVED
STATE CORPORATION COMMISSION

AUG 17 1964
08-17-1964
CONSERVATION DIVISION
Wichita, Kansas

(If additional description is necessary, use BACK of this sheet)


Name of Plugging Contractor Shields Drilling Co.
Address Russell, Kansas

STATE OF Kansas, COUNTY OF Russell Sedgwick, ss.
Athol C. Barton (employee of owner) or (owner or operator) of the above-described well, being first duly sworn on oath, says: That I have knowledge of the facts, statements, and matters herein contained and the log of the above-described well as filed and that the same are true and correct. So help me God.

(Signature) Athol C. Barton

SUBSCRIBED AND SWORN to before me this 17th day of August, 1964
Edward S. Frenkel (Address) _____
Notary Public.

My commission expires 11-5-67

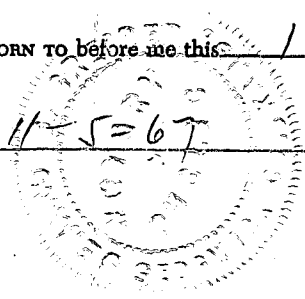

15-1167-05004-00-00

9

Company: Barton Brothers Oil Co.
Farm: Mai #1

Sec. 22 T13 R15W
SE SW SE

Total Depth. 3339
Comm. 7-15-64 Comp. 7-21-64

460
955 Shale Shells & Red Bed
990 Anhydrite
1260 Shale Shells and Salt
1620 Shale, Shells, lime sks
1700 Lime with shale
1905 Lime
2050 Lime
2125 Lime
2235 Lime with shale
2400 Shale and shells
2635 Shale with lime
2806 Shale with lime
2900 Lime
2970 Lime
3210 Lime
3320 Lime
3339 Lime

RECEIVED
STATE CORPORATION COMMISSION

AUG 17 1964
08-17-1964
CONSERVATION DIVISION
Wichita, Kansas