

15-167-06483-00-00


STATE OF KANSAS
STATE CORPORATION COMMISSION

WELL PLUGGING RECORD

Give All Information Completely
Make Required Affidavit
Mail or Deliver Report to:
Conservation Division
State Corporation Commission
800 Bitting Building
Wichita, Kansas

Russell County, Sec. 23 Twp. 13 Rge. 15 (E) (W)
Location as "NE/CNW $\frac{1}{4}$ SW $\frac{1}{4}$ " or footage from lines SE SW SW
Lease Owner Cyrus N. Peterson
Lease Name Dockendorf Well No. 1
Office Address Luray, Kansas
Character of Well (completed as Oil, Gas or Dry Hole) Dry Hole
Date well completed October 9, 1950
Application for plugging filed October 9, 1950
Application for plugging approved October 9, 19 50
Plugging commenced October 9, 19 50
Plugging completed October 9, 19 50
Reason for abandonment of well or producing formation _____

NORTH

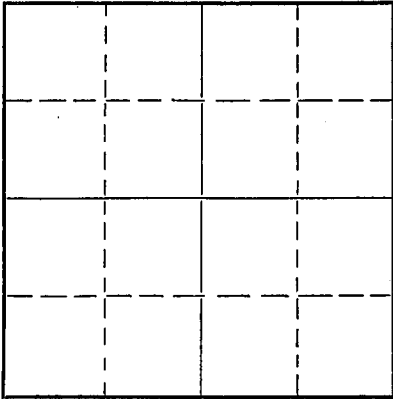

Locate well correctly on above
Section Plat

If a producing well is abandoned, date of last production _____ 19____
Was permission obtained from the Conservation Division or its agents before plugging was commenced? yes

Name of Conservation Agent who supervised plugging of this well Mr. Eldon Petty
Producing formation _____ Depth to top _____ Bottom _____ Total Depth of Well 3369 Feet
Show depth and thickness of all water, oil and gas formations.

OIL, GAS OR WATER RECORDS

CASING RECORD

Formation	Content	From	To	Size	Put In	Pulled Out
				10-3/4"		cmd. w/110

Describe in detail the manner in which the well was plugged, indicating where the mud fluid was placed and the method or methods used in introducing it into the hole. If cement or other plugs were used, state the character of same and depth placed, from _____ feet to _____ feet for each plug set.

Heavey mud to 150'
Bridge & Plug @ 150'
20 sxs. cement
Mud to 20'
Bridge & Plug @ 20'
10 sxs. cement


12-13-1950

(If additional description is necessary, use BACK of this sheet)
Correspondence regarding this well should be addressed to Stearns Drilling Co.
Address Russell, Kansas

STATE OF Kansas, COUNTY OF Russell, ss.
O. E. Stearns (employee of owner) or (owner or operator) of the above-described well,
being first duly sworn on oath, says: That I have knowledge of the facts, statements, and matters herein contained and the log of the above-described well as filed and that the same are true and correct. So help me God.
(Signature) O. E. Stearns

SUBSCRIBED AND SWORN to before me this 11th day of December, 1950
Paul Dalton Notary Public.

My commission expires June 20, 1953

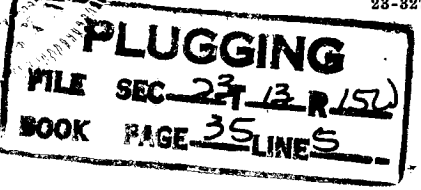

CYRUS PETERSON - DOCKENDORF # 1

Commencement date: 9-25-50
 Completion date: 10- 9-50
 Company: Stearns Drilling Company

Location: SE SW SW, Sec. 23-T13-R15,
 Russell County, Kansas.
 Elevation: 1887' D. F.

Casing Record:

8-5/8" 159'

Totco:

10 765'
 15 min. 1204'
 30 min. 1850'
 45 min. 2600'

WELL LOG

shale	0	40
clay and sand	40	95
shale, sand, shells	95	159
shale and iron	159	200
shale and sand	200	465
sand and iron	465	470
shale and sand	470	580
red rock	580	953
<u>Anhydrite</u>	953	985
shale and shells	985	1485
salt	1485	1510
shale and shells	1510	1590
broken lime	1590	2020
lime and shale	2020	2783
lime	2783	2978
shale	2978	3007
<u>Heebner shale</u>	3007	3011
lime	3011	3291
lime and shale	3291	3321
conglomerate	3321	3362
<u>Arbuckle</u>	3362	3369
<u>Total Depth</u>		3369

RECORDED
 12-13-1950

STATE OF KANSAS)
) SS
 COUNTY OF RUSSELL)

I hereby certify that the above information is true and correct to the best of my knowledge.

[Signature]

SUBSCRIBED and sworn to before me this 11th day of December 1950

[Signature]
 Notary Public

My commission expires: June 20, 1953

PLUGGING
 FILE SEC 23 T 13 R 15
 BOOK PAGE 35 LINE 5