

NOTICE OF INTENTION TO DRILL

(see rules on reverse side)

Starting Date June 20 1986 month day year

API Number 15- 019-25,255-0000

OPERATOR: License # 4780

Lot 1 NW 7 35 S, Rg 12 East
4820 Ft. from South Line of Section
4460 Ft. from East Line of Section

Name Midwest Enterprises, Inc.

Address 1081 Parklane - Suite 120-121

City/State/Zip Wichita, Kansas 67218

Contact Person Leonard L. Rising

Phone 316-681-0383

CONTRACTOR: License # 9350

Name Thompson Drilling Co.

City/State Independence, Ks. 67301

Well Drilled For: Well Class: Type Equipment:

X Oil SWD X Infield X Mud Rotary
Gas Inj Pool Ext. Air Rotary
OWWO Expl Wildcat Cable

(Note: Locate well on Section Plat on reverse side)
Nearest lease or unit boundary line 440 feet
County Chautauqua
Lease Name Hauptman Well # 6

Ground surface elevation n.a. n.a. feet MSL

Domestic well within 330 feet: yes X no

Municipal well within one mile: yes X no

Depth to bottom of fresh water 150 feet

Depth to bottom of usable water 225 feet

Surface pipe by Alternate: 1 2 X

Surface pipe planned to be set 40 ft.

Conductor pipe required none

Projected Total Depth 2,000 feet

Formation mississippi

If OWWO: old well info as follows:

Operator
Well Name
Comp Date Old Total Depth

I certify that well will comply with K.S.A. 55-101, et seq., plus eventually plugging hole to KCC specifications.

Date 6-19-86 Signature of Operator or Agent Leonard L. Rising Title Secretary-Treasurer

For KCC Use:

Conductor Pipe Required feet; Minimum Surface Pipe Required 40 feet per Alt. 1


This Authorization Expires 12-19-86 Approved By 6-19-86

Must be filed with the K.C.C. five (5) days prior to commencing well  
This card void if drilling not started within six (6) months of date received by K.C.C.

**Important procedures to follow:**

1. Notify District office before setting surface casing.
2. Set surface casing by circulating cement to the top.
3. File completion forms ACO-1 with K.C.C. within 90 days of well completion, following instructions on ACO-1, side 1, and including copies of wireline logs.
4. Notify District office 48 hours prior to old well workover or re-entry.
5. Prior to filing Intent, prepare a proposed plugging plan in case well is D & A, then obtain approval of plan when calling district office prior to setting surface pipe.
6. Submit plugging report (CP-4) to K.C.C. after plugging is completed.
7. Obtain an approved injection docket number before disposing of salt water.
8. Notify K.C.C. within 10 days when injection commences or terminates.
9. If an alternate 2 completion, cement in the production pipe from below any usable water to surface within 120 days of spud date.

**A Regular Section of Land  
1 Mile = 5,280 Ft.**

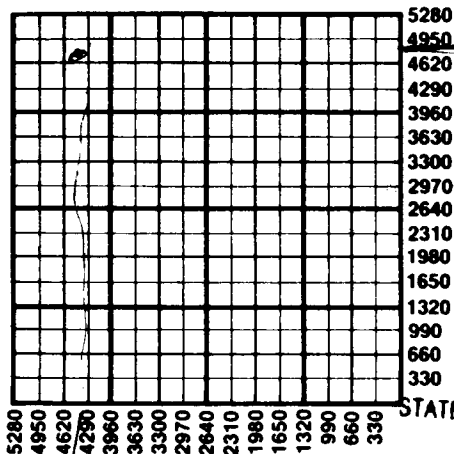

RECEIVED  
STATE CORPORATION COMMISSION

JUN 19 1986

CONSERVATION DIVISION  
Wichita, Kansas

State Corporation Commission of Kansas  
Conservation Division  
200 Colorado Derby Building  
Wichita, Kansas 67202  
(316) 263-3238