


Give All Information Completely  
Make Required Affidavit  
Mail or Deliver Report to:  
Conservation Division  
State Corporation Commission  
800 Biting Building  
Wichita, Kansas

WELL PLUGGING RECORD

15-051-03681-0000

Ellis County, Sec. 14 Twp. 11s Rge. 17 (E) W (W)

Location as "NE/CNW/SW" or footage from lines C NW NW NE  
Lease Owner The Derby Oil Company  
Lease Name Hall Well No. 1  
Office Address P.O. Box 1030, Wichita, Kansas  
Character of Well (completed as Oil, Gas or Dry Hole) Dry hole  
Date well completed Aug. 10 1954  
Application for plugging filed Aug. 10 1954  
Application for plugging approved Aug. 10 1954  
Plugging commenced Aug. 10 1954  
Plugging completed Aug. 10 1954  
Reason for abandonment of well or producing formation Dry Hole

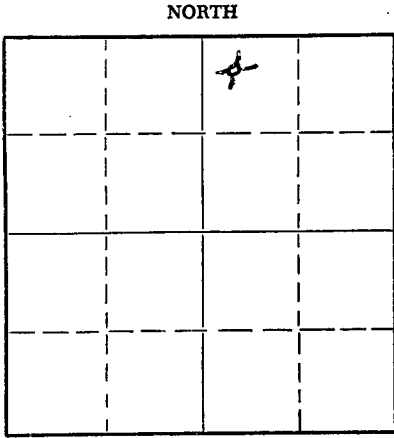

Locate well correctly on above Section Plat

If a producing well is abandoned, date of last production \_\_\_\_\_ 19\_\_\_\_  
Was permission obtained from the Conservation Division or its agents before plugging was commenced? Yes

Name of Conservation Agent who supervised plugging of this well Eldon Petty  
Producing formation \_\_\_\_\_ Depth to top \_\_\_\_\_ Bottom \_\_\_\_\_ Total Depth of Well 3379 Feet  
Show depth and thickness of all water, oil and gas formations.

OIL, GAS OR WATER RECORDS

CASING RECORD

FORMATION	CONTENT	FROM	TO	SIZE	PUT IN	PULLED OUT
		0	1031	8 5/8	1031	None

Describe in detail the manner in which the well was plugged, indicating where the mud fluid was placed and the method or methods used in introducing it into the hole. If cement or other plugs were used, state the character of same and depth placed, from \_\_\_\_\_ feet to \_\_\_\_\_ feet for each plug set.

Filled hole with heavy rotary mud from TD, 3379', to bottom of cellar. Halliburton put in plug and swedge nipple. Pressured up to 400# and pumped 80 sacks cement down from top of hole to a depth of 250'.

08-19-54  
CONSERVATION DIVISION  
WICHITA, KANSAS

(If additional description is necessary, use BACK of this sheet)  
Name of Plugging Contractor Glenn W. Peel  
Address P.O. Box 359, Hoisington, Kansas

STATE OF KANSAS, COUNTY OF BARTON, ss.  
Glenn W. Peel (employee of owner) or (~~owner or operator~~) of the above-described well, being first duly sworn on oath, says: That I have knowledge of the facts, statements, and matters herein contained and the log of the above-described well as filed and that the same are true and correct. So help me God. GLENN W. PEEL

(Signature) BY: Maniam M. Herbert  
P.O. Box 359, Hoisington, Kansas  
(Address)

SUBSCRIBED AND SWORN TO before me this 12<sup>th</sup> day of August, 19 54

My commission expires June 4, 1955 Maniam M. Herbert Notary Public.

**PLUGGING**  
FILE SEC 14 T 11 R 17W  
BOOK PAGE 56 LINE 40

DRILLERS' LOG

Company: The Derby Oil Company

C NW NW NE  
Sec. 14, Twp. 11S, Rge 17W,

Farm Name: Hall Well No. 1

County: Ellis,  
Kansas

Total Depth: 3379'

Comm: 7-29-54 Comp: 8-10-54  
Contractor: Glenn W. Peel

Production: Dry

Casing: 1031' 8 5/8" cem.

Elevation: 1818 KB

15-051-03681-0000

Figures below indicate bottoms of formations:

Sand	0 -	130
Sand and shale		1025
Anhydrite		1050
Shale		1580
Lime		2000
Lime and shale		2475
Shale		2715
Lime		3379
Total Depth		3379

This is to certify that the above information is to the best of our knowledge, true and correct.

GLENN W. PEEL

BY: Way Herbert

SUBSCRIBED AND SWORN to before me this 12<sup>th</sup> day of August, 1954.

My commission expires: June 4, 1955

Manan M. Herbert  
Notary Public

GEOLOGICAL INFORMATION:

HEEBNER	2981	-1163
TORONTO	3002	-1184
LANSING	3023	-1205
CONGL	3285	-1467
SIMP. Dol.	3351	-1533
ARBUCKLE	3375	-1557

RECEIVED  
STATE CORPORATION COMMISSION  
AUG 19 1954  
CONSERVATION DIVISION  
Wichita, Kansas

PLUGGING  
FILE SEC. 14 T 11 R 17W  
BOOK PAGE 54 LINE 40