


WELL PLUGGING RECORD

15-051-01678-0091

Ellis

County, Sec. 14, Twp. 11S, Rge. 17W (W)

Location as "NE, CNW, SW" or footage from lines SW 5W SW
 Lease Owner Richard Zinszer
 Lease Name HALL Well No. 1-A
 Office Address 206 W 26 St Hays Kansas
 Character of Well (completed as Oil, Gas or Dry Hole) RE-Entered abandoned well
 Date well completed _____ 19____
 Application for plugging filed Leo Massey Aug 1 19 78
 Application for plugging approved ✓ Aug 10 19 78
 Plugging commenced _____ 19____
 Plugging completed August 19 19 78
 Reason for abandonment of well or producing formation Could not enter old hole due to JUNK
 If a producing well is abandoned, date of last production _____ 19____
 Was permission obtained from the Conservation Division or its agents before plugging was commenced? Yes - Leo Massey

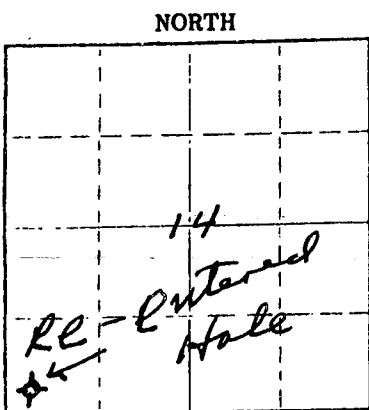

Locate well correctly on above Section Plat

Name of Conservation Agent who supervised plugging of this well _____
 Producing formation Arbuschle Depth to top _____ Bottom _____ Total Depth of Well 3440 Feet
 Show depth and thickness of all water, oil and gas formations. Plg'd by Cities Service 1947

OIL, GAS OR WATER RECORDS

CASING RECORD

FORMATION	CONTENT	FROM	TO	SIZE	PUT IN	PULLED OUT
<u>Re-entered Plugged well - junk at 450ft</u>						
<u>Could not recover - Plugged well</u>						

Describe in detail the manner in which the well was plugged, indicating where the mud fluid was placed and the method or methods used in introducing it into the hole. If cement or other plugs were used, state the character of same and depth placed, from _____ feet to _____ feet for each plug set.

Fluid level 30ft from surface ran in 6x6 inch pipe then rocks and cement to surface.

Name of Plugging Contractor Shimone Construction (If additional description is necessary, use BACK of this sheet)
 Address East - 40 Highway, Hays Kansas

STATE OF Kansas COUNTY OF Ellis SS.
Richard H. Zinszer (employee of owner) or (owner operator) of the above-described

well, being first duly sworn on oath, says: That I have knowledge of the facts, statements, and matters herein contained and the log of the above-described well as filed and that the same are true and correct. So help me God.

(Signature) Richard H. Zinszer
206 W 26 St Hays Kansas (Address)

Subscribed and sworn to before me this 28th day of August 1978



My commission expires _____ Notary Public.

RECEIVED
 STATE CORPORATION COMMISSION
 STATE CORPORATION COMMISSION
 AUG 30 1978
 AUG 25 1978
 CONSERVATION DIVISION
 Wichita, Kansas
 CONSERVATION DIVISION
 Wichita, Kansas