


WELL PLUGGING RECORD  
OR 15-051-03677-0000  
FORMATION PLUGGING RECORD

Strike out upper line when reporting plugging of formations.

Give All Information Completely  
Make Required Affidavit  
Mail or Deliver Report to:  
Conservation Division  
State Corporation Commission  
800 Bittig Building  
Wichita, Kansas

NORTH

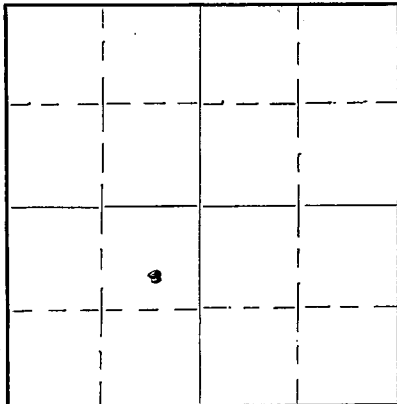

Locate well correctly on above Section Plat

Ellis County, Sec. 14 Twp. 11 Rge. 17 (E) 17 (W)  
Location as "NE 1/4 NW 1/4 SW 1/4" or footage from lines 990'S 660'W from center  
Lease Owner: Cities Service Oil Company  
Lease Name: Hall "A"  
Office Address: Bartlesville, Oklahoma. Well No. 6  
Character of Well (completed as Oil, Gas or Dry Hole): Dry Hole  
Date, well completed: May 15, 1940 193  
Application for plugging filed: May 16, 1940 193  
Application for plugging approved: May 16, 1940 193  
Plugging Commenced: May 17, 1940 193  
Plugging Completed: May 17, 1940 193  
Reason for abandonment of well or producing formation: Dry Hole

If a producing well is abandoned, date of last production 193  
Was permission obtained from the Conservation Division or its agents before plugging was commenced? Yes

Name of Conservation Agent who supervised plugging of this well: C.T. Alexander  
Producing formation: Arbuckle lime Depth to top: 3522 Bottom: Total Depth of Well: 3593 Feet  
Show depth and thickness of all water, oil and gas formations.


OIL, GAS OR WATER RECORDS

CASING RECORD

Formation	Content	From	To	Size	Put In	Pulled Out
Arbuckle lime	Dry			8 5/8"	1062'	None

Describe in detail the manner in which the well was plugged, indicating where the mud fluid was placed and the method or methods used in introducing it into the hole. If cement or other plugs were used, state the character of same and depth placed, from \_\_\_\_\_ feet to \_\_\_\_\_ feet for each plug set.

Filled with mud from total depth 3593' to 1016' set wood plug at 1016'  
filled with mud to 18' dumped 10 sacks filled with mud and dirt to surface.

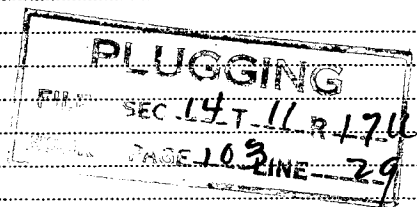

(If additional description is necessary, use BACK of this sheet)

Correspondence regarding this well should be addressed to: R.C. Hauber  
Address: Cities Service Oil Company Great Bend, Kansas

STATE OF Kansas, COUNTY OF Russell, ss.  
J.A. Cleverley (employee of owner) or (owner or operator) of the above-described well,  
being first duly sworn on oath, says: That I have knowledge of the facts, statements, and matters herein contained and the log of the above-described well as filed and that the same are true and correct. So help me God.

(Signature)

Cities Service Oil Company Russell, Kansas (Address)

SUBSCRIBED AND SWORN TO before me this 29 day of May

January 26, 1942

My commission expires

Notary Public

WELL RECORD

Company Cities Service Oil Company Well No. 6 Farm Hall "A"  
 Location 990' south & 660' west of Center Sec. 14 T. 11 R. 17-W  
 Elevation 1840 County Ellis State Kansas  
 Drlg. Comm. April 27, 1940 Contractor Mabee Oil & Gas Company  
 Drlg. Comp. May 15, 1940 Acid None  
 T. D. 3393' Initial Prod. Dry - P. & A. 15-051-03677-0000

CASING RECORD:

8-5/8" 1062' cem. 285 sx Monarch &  
 25 sx High Early; 137  
 sx cement around top  
 of pipe. Left in.

lime (cored, rec. 5') 3389  
 lime 3390  
 lime (cored, rec. 4") 3393

FORMATION RECORD:

sand 0-90  
 shale & shells 610  
 sand 720  
 shale & shells 1045  
 shale 1062  
 anhydrite lime 1095  
 red bed 1166  
 red bed & shells 1322  
 shale & shells 1445  
 shale & salt 1590  
 shale & shells 1950  
 lime broken 1966  
 shale & lime 2036  
 lime 2112  
 shale & shells & red rock 2240  
 shale 2316  
 shale & lime 2393  
 shale & lime shells 2465  
 broken lime 2485  
 shale & shells 2630  
 shale & lime 2663  
 shale & shells 2752  
 shale & lime 2844  
 lime 2886  
 lime broken 2911  
 lime 3010  
 broken lime 3030  
 lime 3080  
 broken lime 3203  
 lime 3245  
 broken lime 3325  
 red bed 3330  
 shale 3339  
 lime 3350  
 lime & shale 3370  
 conglomerate 3383

Top Arbuckle 3383  
 Penetration 10'  
 Total Depth 3393

Halliburton drill stem test 3383-93  
 showed 270' fluid (100' sulphur  
 water and 170' mud with some oil)  
 in 45 mins.

SYFO: 500' 00  
 1000' 00  
 1500' 00  
 2000' 00  
 2500' 00  
 3250' 00

**PLUGGING**  
 FILE SEC. 14T-11-R-174  
 BOOK PAGE 103 LINE 29

