


WELL PLUGGING RECORD

Give All Information Completely  
Make Required Affidavit  
Mail or Deliver Report to:  
Conservation Division  
State Corporation Commission  
800 Bitting Building  
Wichita, Kansas

Ellis County, Sec. 15, Twp. 11S, Rge. 17W(E) (W)

Location as "NE/CNW $\frac{1}{4}$ SW $\frac{1}{4}$ " or footage from lines SW SW NW  
Lease Owner The Texas Company  
Lease Name F. A. Bemis "B" Well No. 1  
Office Address 614 Bitting Building, Wichita, Kansas  
Character of Well (completed as Oil, Gas or Dry Hole) Oil  
Date well completed April 6 19 37  
Application for plugging filed July 9 19 52  
Application for plugging approved July 10 19 52  
Plugging commenced July 14 19 52  
Plugging completed July 15 19 52  
Reason for abandonment of well or producing formation  
Ceased to be a commercial producer  
If a producing well is abandoned, date of last production May 19 51  
Was permission obtained from the Conservation Division or its agents before plugging was commenced? Yes

NORTH

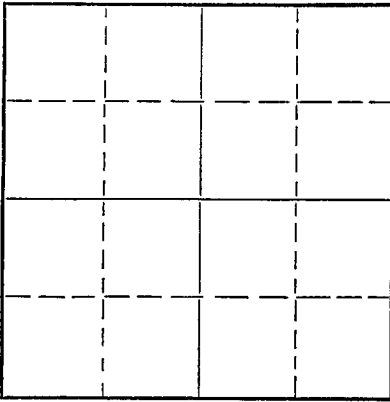

Locate well correctly on above  
Section Plat

Name of Conservation Agent who supervised plugging of this well Mr. Eldon Petty  
Producing formation Arbuckle Depth to top 3421 Bottom 3424 Total Depth of Well 3424 Feet  
Show depth and thickness of all water, oil and gas formations.

OIL, GAS OR WATER RECORDS

CASING RECORD

Formation	Content	From	To	Size	Put In	Pulled Out
				15-1/2"	121'	0'
				10-3/4"	1122'	0'
				7"	3455'	2291'

Describe in detail the manner in which the well was plugged, indicating where the mud fluid was placed and the method or methods used in introducing it into the hole. If cement or other plugs were used, state the character of same and depth placed, from \_\_\_\_\_ feet to \_\_\_\_\_ feet for each plug set.

PLUGGED AS FOLLOWS:


3424 to 2900' - Sand  
2900' to 2875' - 5 Sacks Cement  
2875 to 300' - Heavy Mud  
300 to 290' - Rock  
290 to 240' - 25 Sacks Cement  
240 to 35' - Heavy Mud  
35 to 30' - Rock  
30' to bottom of cellar - 15 Sacks Cement

(If additional description is necessary, use BACK of this sheet)

Name of Plugging Contractor Jayhawk Well Servicing Company  
Address Russell, Kansas

STATE OF Kansas, COUNTY OF Sedgwick, ss.  
M. C. Harrell (employee of owner) or (owner or operator) of the above-described well,

being first duly sworn on oath, says: That I have knowledge of the facts, statements, and matters herein contained and the log of the above-described well as filed and that all same are true and correct. So help me God.

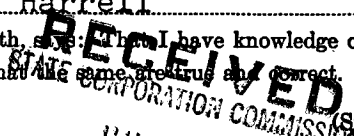


(Signature) M. C. Harrell  
614 Bitting Building, Wichita, Kansas

(Address)

SUBSCRIBED AND SWORN to before me this 15th day of July, 19 52

H. Howard Kistler  
Notary Public.

My commission expires September 20, 1952

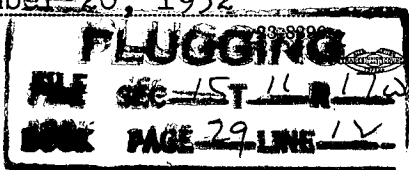



15-051-03683-0000

FORM PO-214 Sheet 2 (4-51) 50M

## LOG OF WELL

SHEET NO. \_\_\_\_\_

District Kansas Owner The Texas Company Farm F. A. Bemis "B" Well No. 1

FORMATION		AMOUNT	COLOR	HARD OR SOFT	DEPTH CORES TAKEN	REMARKS	
Soil, Sand & Shale	123	123				Set & Cemented Surface with 15-1/2" at 120' 60 sks.	
Lime	338	215					
Shale & Lime Shells	440	102					
Lime	500	60					
Shale	600	100					
Lime	635	35					
Sand	745	110					
Shale & Lime Shells	805	60					
Shale	835	30					
Lime	860	25					
Lime Hard	885	25					
Broken Lime	903	18					
Shale & Lime Shells	1075	172					
Lime	1080	5					
Broken Lime	1090	10					
Chalk	1097	7					
Anhydrite	1107	10					
Anhydrite	1120	13					Cemented 10" Casing at 1112' 500 sks.
Red Bed & Lime Shells	1125	5					
Red Bed	1204	79					
Lime	1350	146					
Shale	1579	229					
Brown Shale	1620	41					
Shale & Lime Shells	1640	20					
Shale	1670	30					
Broken Lime	1747	77					
Lime	1825	78					
Shale	1910	85					
Lime Hard	1962	52					
Lime	2428	466					
Sticky Shale	2516	88					
Shale	2668	152					
Broken Lime	2702	34					
Shale	2843	141					
Lime	3373	530					
Conglomerate	3407-1/2	34-1/2				Lost Circulation at 2898'.	
Lime	3414	6-1/2					
Lime Cored	3424	10				7" O.D. Set 3421' w/ 100 sks.	
Total Depth	3424'						

874  
 CONSERVATION  
 WICHITA