

WELL PLUGGING RECORD

Give All Information Completely
Make Required Affidavit
Mail or Deliver Report to:
Conservation Division
State Corporation Commission
800 Bittling Building
Wichita, Kansas

Ellis County, Sec. 15 Twp. 11S Rge. 17 (A) (W)

Location as "NE/CNW/SW" or footage from lines SW/4 SE/4 NW/4

Lease Owner Walters Drilling Co., Inc.

Lease Name Bemis Well No. 1

Office Address 510 Orpheum Building, Wichita, Kansas

Character of Well (completed as Oil, Gas or Dry Hole) Dry Hole

Date well completed February 6, 19 54

Application for plugging filed (verbal) February 6, 19 54

Application for plugging approved (verbal) February 6, 19 54

Plugging commenced February 6, 19 54

Plugging completed February 6, 19 54

Reason for abandonment of well or producing formation Dry Hole

If a producing well is abandoned, date of last production 19

Was permission obtained from the Conservation Division or its agents before plugging was commenced? Yes

Name of Conservation Agent who supervised plugging of this well Mr. Eldon Petty, Hays, Kansas

Producing formation Depth to top Bottom Total Depth of Well 3421 Feet

Show depth and thickness of all water, oil and gas formations.

OIL, GAS OR WATER RECORDS

CASING RECORD

FORMATION	CONTENT	FROM	TO	SIZE	PUT IN	PULLED OUT
None	None	0	193'	8 5/8"	193'	None
	Cemented with 100 sacks cement and 1 Cal. Chloride					
	(No oil string run - dry and abandoned)					

Describe in detail the manner in which the well was plugged, indicating where the mud fluid was placed and the method or methods used in introducing it into the hole. If cement or other plugs were used, state the character of same and depth placed, from feet to feet for each plug set.

Filled hole with mud to top, put in plug and squeezed with 60 sacks cement.

(If additional description is necessary, use BACK of this sheet)

Name of Plugging Contractor Globe Oilwell Cementing Company

Address Great Bend, Kansas

STATE OF Kansas, COUNTY OF Sedgwick, ss. Robert F. Walters (employee of owner) of the above-described well, being first duly sworn to before me this 9th day of February, 19 54

That I have knowledge of the facts, statements, and matters herein contained and the log of the above-described well as filed and that the same are true and correct. So help me God.

(Signature) Robert F. Walters

510 Orpheum Bldg., Wichita, Kansas (Address)

SUBSCRIBED AND SWORN TO before me this 9th day of February, 19 54

Pauline Hendriksen

Notary Public.


My commission expires March 10, 1956

PLUGGING
FILE SEC 15 T 11 R 17W
BOOK PAGE 12 LINE 25

RWD
02-10-54

17W

NORTH

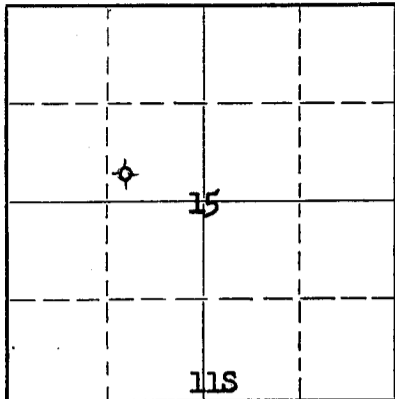

Locate well correctly on above Section Plat

BEMIS NO. 1

Location:	SW SE NW Sec. 15-11S-17W Ellis County, Kansas	Date Spudded: 1-25-54
Operator:	Walters Drilling Co., Inc.	Rotary Completion: 2-6-54
Contractor:	Walters Drilling Co., Inc.	Elevation: 1968 Gr 1872 DF 1874 KB
Surface Casing:	8 5/8" set at 193' with 100 sacks cement and 1 sack Cal. Chloride	
Oil String:	None. D & A	

L O G

(Figures indicate bottom of formation)

Surface	0 to 193
Shale and Shells	250
Sand and Shale	360
Shale and Shells	627
Sand	770
Shale	1090
Anhydrite	1126
Shale and Shells	1965
Shale and Lime Shells	2000
Lime	2180
Shale and Lime	2824
Lime	3038
Lime and Shale	3079
Lime	3351
Cherty Lime	3380
Lime and Shale	3421
Total Depth	3421

The undersigned, Robert F. Walters, hereby certifies that the above log is a true and correct log of the formations encountered in drilling the above noted well as reflected by the Daily Drilling Reports.

WALTERS DRILLING CO., INC.

By Robert F. Walters

Subscribed and sworn to before me
this 9th day of February, 1954.

Pauline R. Hendrickson
Notary Public

My commission expires: March 10, 1956

PLUGGING
FILE SEC 15 T 11 R 17W
BOOK PAGE 12 LINE 25