


WELL PLUGGING RECORD

OR 15-051-19324-0000

FORMATION PLUGGING RECORD Strike out upper line when reporting plugging off formations.

Give All Information Completely
Make Required Affidavit
Mail or Deliver Report to:
Conservation Division
State Corporation Commission
800 Bitting Building
Wichita, Kansas

Ellis County. Sec. 15 Twp. 11 Rge. ~~17~~ 17 (W)
Location as "NE $\frac{1}{4}$ NW $\frac{1}{4}$ SW $\frac{1}{4}$ " or footage from lines. SW SW
Lease Owner Sohio Petroleum Company
Lease Name Bemis "B" Well No. S.W.D.
Office Address Box 671, Russell, Kansas
Character of Well (completed as Oil, Gas or Dry Hole) Salt water well
Date well completed May, 1939 19
Application for plugging filed 5-13-49 19
Application for plugging approved 5-17-49 19
Plugging commenced 9-13-49 19
Plugging completed 9-13-49 19
Reason for abandonment of well or producing formation Not needed
If a producing well is abandoned, date of last production -- 19
Was permission obtained from the Conservation Division or its agents before plugging was commenced? Yes

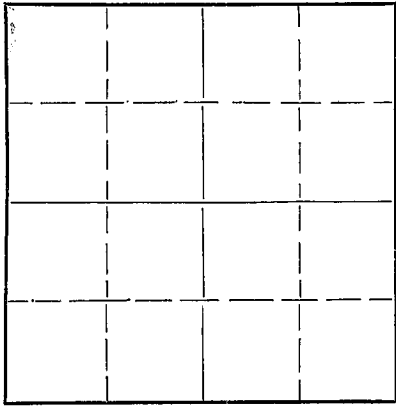

Locate well correctly on above Section Plat

Name of Conservation Agent who supervised plugging of this well Eldon Petty
Producing formation Depth to top Bottom Total Depth of Well 784 Feet
Show depth and thickness of all water, oil and gas formations.

OIL, GAS OR WATER RECORDS

CASING RECORD

Formation	Content	From	To	Size	Put In	Pulled Out
Shale				10 3/4	61'	None
Shale				7"	650'	None

Describe in detail the manner in which the well was plugged, indicating where the mud fluid was placed and the method or methods used in introducing it into the hole. If cement or other plugs were used, state the character of same and depth placed, from feet to feet for each plug set.

784' to 100' Heavy Mud
100' to 0' 128 Sacks of Cement

(If additional description is necessary, use BACK of this sheet)

Correspondence regarding this well should be addressed to Sohio Petroleum Company
Address Box 671
Russell, Kansas

STATE OF KANSAS, COUNTY OF RUSSELL, ss.
J. H. BOND (employee of owner) of the above-described well,
being first duly sworn on oath, says: That I have knowledge of the facts, statements, and matters herein contained and the log of the above-described well as filed and that the same are true and correct. So help me God.

(Signature)


J. H. Bond

(Address)

SUBSCRIBED AND SWORN TO before me this 19th day of September, 1949

Russell Merrill
Notary Public.

My commission expires M. Commission Expires July 2, 1953

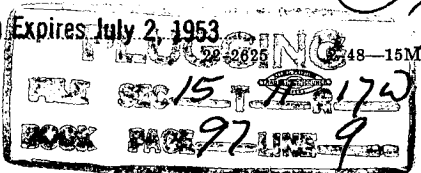

DISPOSAL WELL - No. B SWD, Bemis Lease, Ellis County, Kansas
Sohio Petroleum Company

0-4	Cellar
4-20	Rock & Clay
20-150	Blue Shale
150-224	Blue Shale & Lime Shells
224-265	Blue Shale
265-324	Gray Shale
324-343	Water Sand
343-346	Gray Shale
346-351	Hard Lime
351-359	Gray Shale
359-380	Red Bed
380-390	Gray Shale
390-409	Red Bed
409-428	Gray Shale
428-468	Red Bed
468-472	Gray Shale
472-495	Sand HFW
495-497	Iron & Sand
497-500	Blue Shale
500-507	Gray Shale
507-518	Sand
518-523	Blue Shale
523-531	Sand & Shale
531-544	Blue Shale
544-559	Gray Shale
559-566	Blue Shale
566-568	Lime & Iron
568-584	Gray Shale
584-598	Hard Lime
598-605	Sand
605-613	Blue Shale
613-628	Blue Shale & Shells
628-630	Lime
630-631	Blue Shale
631-633	Lime
633-638	Iron & Blue Shale
638-690	Sand & Iron
690-753	Sand
753-764	White Sand
764-784	Red Rock
784	Total Depth

Casing Record

Run 61'5" of 10" Casing and pumped cement. Around 60 sacks used.
Run 442' of 8" Casing.
Run 7" pipe at 584.
Reamed from 584 to 634 and lowered 7".
Reamed from 634 to 646 and lowered 7".
Cemented here with 300 sacks cement which circulated measurement on 7" from cellar.

Drilled by: Enoch & Burrows
Water Well Co.,
Holyrood, Kansas.

Well flowing about 25 barrels per hour.

