

STATE OF KANSAS  
STATE CORPORATION COMMISSION

Give All Information Completely  
Make Required Affidavit  
Mail or Deliver Report to:  
Conservation Division  
State Corporation Commission  
211 No. Broadway  
Wichita, Kansas

WELL PLUGGING RECORD

Ellis County, Sec. 16 Twp. 11S Rge. (E) 17 (W)

Location as "NE/CNW%SW%" or footage from lines SE SW NE

Lease Owner Okmar Oil Co.

Lease Name Bemis Well No. 1

Office Address 817 Union National Bldg., Wichita, Kansas

Character of Well (completed as Oil, Gas or Dry Hole) Dry Hole

Date well completed 7-24-57 19

Application for plugging filed 7-24-57 19

Application for plugging approved 7-24-57 19


Plugging commenced 7-24-57 19

Plugging completed 7-24-57 19

Reason for abandonment of well or producing formation Dry Hole

If a producing well is abandoned, date of last production 19

Was permission obtained from the Conservation Division or its agents before plugging was commenced? Yes

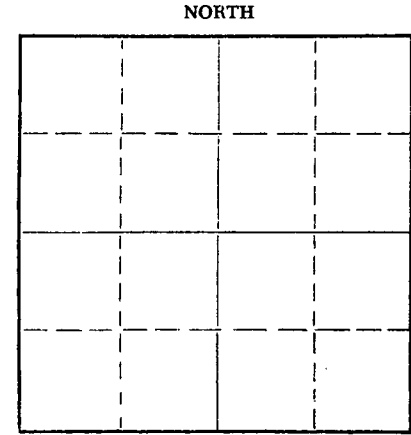

Locate well correctly on above Section Plat

Name of Conservation Agent who supervised plugging of this well Eldon Petty

Producing formation Depth to top Bottom Total Depth of Well Feet

Show depth and thickness of all water, oil and gas formations.

OIL, GAS OR WATER RECORDS

CASING RECORD

FORMATION	CONTENT	FROM	TO	SIZE	PUT IN	PULLED OUT
				8 5/8	1051'	

Describe in detail the manner in which the well was plugged, indicating where the mud fluid was placed and the method or methods used in introducing it into the hole. If cement or other plugs were used, state the character of same and depth placed, from feet to feet for each plug set.

1st Plug @ 500' with 25 sacks cement.  
2nd Plug @ 240' with 25 sacks cement  
Top Plug @ 40' with 10 sacks cement.

(If additional description is necessary, use BACK of this sheet)

Name of Plugging Contractor Leben Drilling, Inc.

Address 905 Central Bldg.

STATE OF Kansas, COUNTY OF Sedgwick  
I, Frank Hamlin, Contractor, ss.

(employee of owner) or (owner or operator) of the above-described well, being first duly sworn on oath, says: That I have knowledge of the facts, statements, and matters herein contained and the log of the above-described well as filed and that the same are true and correct. So help me God.


(Signature) Frank Hamlin

905 Central Bldg., Wichita, Kansas (Address)

SUBSCRIBED AND SWORN to before me this 19th day of September, 19 57

My commission expires June 17, 1961

Ruth N. Benjamin Notary Public.

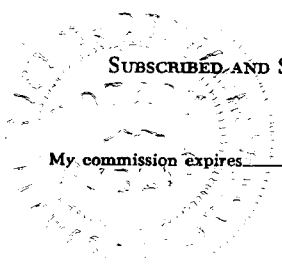

FILED  
SEP 20 1957  
CONSERVATION DIVISION  
WICHITA, KANSAS

PLUGG 3  
FILE SEC. 16 T. 11 R. 17 W  
BOOK PAGE 31 LINE 15

CONTRACTOR'S WELL LOG

COMPANY:  
CONTRACTOR:  
FARM:  
LOCATION:  
COMMENCED:  
COMPLETED:

OKMAR OIL COMPANY  
LEBEN DRILLING, INC.  
BEMIS #1  
SE SW NE SEC. 16-11S-17W  
ELLIS COUNTY, KANSAS  
7-14-57  
7-24-57

0	40	Sand & Clay
40	460	Sand, Ft. Hays Lime & Shale
460	475	Shale
475	540	Sand & Purite
540	730	Shale
730	850	Redbed & Shells
850	1045	Redbed
1045	1100	Anhydrite
1100	1200	Redbed & Shells
1200	1530	Shale & Shells
1530	2865	Shale & Lime
2865	2955	Lime & Shale
2955	3325	Lime
3325	3345	Conglomerate
3345	3375	Lime & Shale
3375	3416	Conglomerate
	3416	<u>Rotary Total Depth - D &amp; A</u>

Set 8 5/8" surface casing at 1051' with 500 sacks cement & 2% CaCl.

I, Frank Hamlin, do hereby certify that the above and foregoing is a true and correct copy of the log of the Bemis #1, SE SW NE Section 16, Township 11 South, Range 17 West, Ellis County, Kansas, as reflected by the files of Leben Drilling, Inc.

LEBEN DRILLING, INC.

By: Frank Hamlin  
Frank Hamlin

STATE OF KANSAS ) ss.  
COUNTY OF SEDGWICK)

Subscribed and sworn to before me, a Notary Public, in and for Sedgwick County, Kansas, this 19th day of September, 1957.

Ruth N. Benjamin  
Ruth N. Benjamin - Notary Public

My commission expires June 17, 1961.

PLUGGING  
FILE SEC. 16 T. 11 R. 17W  
BOOK PAGE 31 LINE 15