

STATE OF KANSAS
STATE CORPORATION COMMISSION

WELL PLUGGING RECORD

Give All Information Completely
Make Required Affidavit
Mail or Deliver Report to:
Conservation Division
State Corporation Commission
800 Bitting Building
Wichita, Kansas

Ellis County, Sec. 16 Twp. 11S Rge. 17 (W)

Location as "NE/CNW/SW" or footage from lines NE NE NE

Lease Owner Derby Oil Company

Lease Name Bemis Well No. 1

Office Address Box 1030 Wibhita

Character of Well (completed as Oil, Gas or Dry Hole) Dry Hole

Date well completed 4-5 19 53

Application for plugging filed 4-4 19 53

Application for plugging approved 4-4 19 53


Plugging commenced 4-5 4:00 A. M. 19 53

Plugging completed 5-5 8:00 A. M. 19 53

Reason for abandonment of well or producing formation Dry Hole

If a producing well is abandoned, date of last production 19

Was permission obtained from the Conservation Division or its agents before plugging was commenced? Yes Verbal

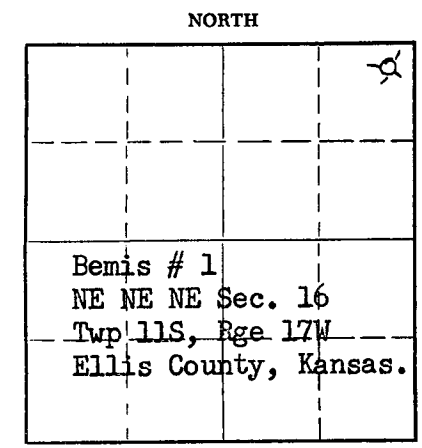

Locate well correctly on above Section Plat

Name of Conservation Agent who supervised plugging of this well Eldon Petty

Producing formation Depth to top Bottom Total Depth of Well Feet

Show depth and thickness of all water, oil and gas formations.

OIL, GAS OR WATER RECORDS

CASING RECORD

FORMATION	CONTENT	FROM	TO	SIZE	PUT IN	PULLED OUT
Soil, Sand, Blue Shale		0	165'	8 5/8	8 5/8	None
Anhydrite		1060	1102			
Lime & Shale		1650	3260			
Cherty Conglomerate		3405	3436			
Total Depth		3436				

Describe in detail the manner in which the well was plugged, indicating where the mud fluid was placed and the method or methods used in introducing it into the hole. If cement or other plugs were used, state the character of same and depth placed, from feet to feet for each plug set.

Stirred pits well, filled with heavy mud to 160' set bottom wood plug. Ran 1/2 sack hulls and 20 sacks of cement. Filled hole with heavy mud to 40' set wood plug ran 1/2 sack hulls and 10 sacks of cement filling to the bottom of the cellar.

(If additional description is necessary, use BACK of this sheet)

Name of Plugging Contractor Strain Drilling Company
Address Box 188 Hays, Kansas.

STATE OF Kansas, COUNTY OF Ellis, ss.
T. C. Strain (employee of owner) or (owner or operator) of the above-described

well, being first duly sworn on oath, says: That I have knowledge of the facts, statements, and matters herein contained and the log of the above-described well as filed and that the same are true and correct. So help me God.


(Signature) [Signature] Box 188 Hays, Kansas.

(Address)

SUBSCRIBED AND SWORN TO before me this 5th, day of May, 19 53

[Signature] Notary Public.

My commission expires March 26, 1956

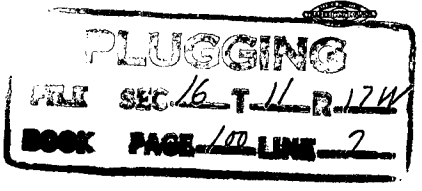

RECEIVED STATE CORPORATION COMMISSION 05-16-53 DIVISION

WELL LOG

COMPANY: Derby Oil Company

NE NE NE Sec. 16
Twp 11S, Rge 17W
Ellis County, Kansas.

LEASE: Bemis # 1

ELEVATION: 1829 R. B.

NOTE: All meas rotary Bushing

0	50 Soil & Sand	3155	3195 Lime
50	70 Blue Shale & Shells	3195	3230 Lime
70	110 Blue Shale & Shells	3230	3260 Lime
110	165 Lime & Shale	3260	3285 Lime
165	300 Blue Shale	3285	3350 Lime
300	320 Sand (not Dakota)	3350	3405 Lime & Shale
320	532 Shale, Sand & Shells	3405	3436 Cherty Conglomerate
532	700 Sand Dakota	3436	(Total Depth)
700	830 Shale, Shells & Redbed		
830	1020 Shale, Redbed & Shells		
1020	1060 Redbed	COMMENCED: 4-25-53	
1060	1102 Anhydrite	COMPLETED: 5-5-53	
1102	1250 Shale & Shells		
1250	1450 Shale & Shells		
1450	1510 Salt & Shale		
1510	1595 Shale & Shells		
1595	1650 Shale & Shells		
1650	1725 Lime & Shale		
1725	1890 Lime & Shale		
1890	2035 Lime & Shale		
2035	2107 Lime & Shale		
2107	2280 Lime & Shale		
2280	2405 Lime & Shale		
2485	2540 Lime & Shale		
2540	2620 Shale & Lime Shells		
2620	2650 Shale & Shells		
2650	2810 Lime & Shale		
2810	2865 Lime		
2865	2945 Shale & Lime		
2945	3005 Shale & Lime		
3005	3040 Lime		
3040	3100 Lime		
3100	3155 Lime		

CASING RECORD:

8 5/8 Surface Casing set at 165' W/125 sacks of cement by Globe Cementing Co.

D.S.T. by Johnston Testers

3225-3260 Tool open 1 hour. Weak blow for 3 minutes. Recovered 10' drilling mud. 15 min. B.H.P. 0

No Electric Logs Run

Geologist: E. McMeil

TOPS: Geological

Anhydrite	1060 (+ 769)	Conglomerate	3357 (-1528)
Heebner	3033 (-1204)	R. T. Depth	3436 (-1607)
Lansing	3077 (-1248)		

STATE OF KANSAS) SS
COUNTY OF ELLIS)

I hereby affirm that the above and foregoing is a true and correct copy of the log of the Bemis # 1, located NE NE NE Sec. 16 Twp. 11S Rge. 17W, Ellis County, Kansas

CONTRACTOR: Strain Drilling Company

BY: T. C. Strain
T. C. Strain

Subscribed and sworn to before me this 5th day of May 1953.
My commission expires March 26, 1956

Thelud Schneider
Notary Public

PLUGGING
FILE SEC 16 T 11 R 17W
BOOK PAGE 160 LINE 2

CONSERVED
Wichita, Kansas