


Give All Information Completely
Make Required Affidavit
Mail or Deliver Report to:
Conservation Division
State Corporation Commission
800 Bittling Building
Wichita, Kansas

WELL PLUGGING RECORD

15-019-19754-0000

NORTH

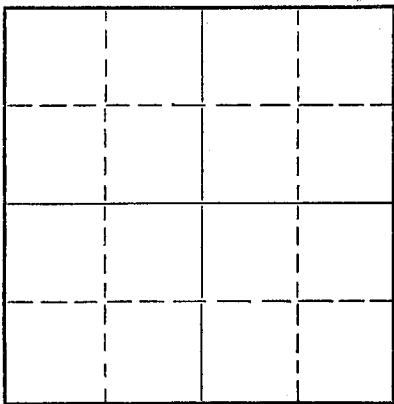

Locate well correctly on above
Section Plat

Chautauqua County. Sec. 6 Twp. 35 Rge. 12 (E) E (W)
Location as "NE/CNW/SW" or footage from lines SW SW
Lease Owner Shannon Bros.
Lease Name Johnston Well No. 2
Office Address Sedan, Kansas
Character of Well (completed as Oil, Gas or Dry Hole) Oil Well
Date well completed 1920's 19
Application for plugging filed November 25, 1953 19
Application for plugging approved November 27, 1953 19
Plugging commenced November 30, 1953 19
Plugging completed December 4, 1953 19
Reason for abandonment of well or producing formation No Production

If a producing well is abandoned, date of last production Not Known 19
Was permission obtained from the Conservation Division or its agents before plugging was commenced? Yes

Name of Conservation Agent who supervised plugging of this well Bert L. Garrett
Producing formation Peru Sand Depth to top 1168' Bottom 1198' Total Depth of Well 1200' Feet
Show depth and thickness of all water, oil and gas formations.

OIL, GAS OR WATER RECORDS

CASING RECORD

FORMATION	CONTENT	FROM	TO	SIZE	PUT IN	PULLED OUT
No Log				10"	20'	20'
				6 1/4"	900'	900'
				2"	1175'	1175'

Describe in detail the manner in which the well was plugged, indicating where the mud fluid was placed and the method or methods used in introducing it into the hole. If cement or other plugs were used, state the character of same and depth placed, from _____ feet to _____ feet for each plug set.

Filled from bottom to 1165' with mud and set 3- Sacks Cement,
Filled with mud from 1165' to 400' and set 3- Sacks Cement, Filled
with mud from 400' to 6' and set 2- Sacks Cement and filled with soil
to top.

(If additional description is necessary, use BACK of this sheet)


Name of Plugging Contractor Shannon Bros.
Address Sedan, Kansas

STATE OF KANSAS, COUNTY OF CHAUTAUQUA, ss.
James E. Shannon (employee of owner) or (owner or operator) of the above-described
well, being first duly sworn on oath, says: That I have knowledge of the facts, statements, and matters herein contained and the log of the
above-described well as filed and that the same are true and correct. So help me God.

(Signature) James E. Shannon
Sedan, Kansas. (Address)

SUBSCRIBED AND SWORN TO before me this 10th day of December, 19 53
Gladys O. Wye Notary Public.
My commission expires November 21, 1957.

24-7368-S 3-53-20M

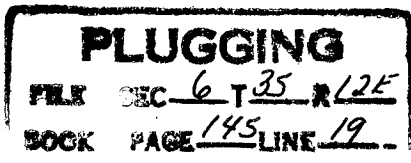

12-11-53