

Give All Information Completely
Make Required Affidavit
Mail or Deliver Report to:
Conservation Division
State Corporation Commission
211 No. Broadway
Wichita, Kansas

WELL PLUGGING RECORD

PRATT

County, Sec. 2 Twp. 26S Rge. 15 (E) 15 (W)

Location as "NE/CNW%SW%" or footage from lines CENTER SW/4 NE/4

Lease Owner REX & MORRIS DRILLING COMPANY AND PETROLEUM, INC.

Lease Name BINGER Well No. 1

Office Address P. O. BOX 334, EL DORADO, KANSAS

Character of Well (completed as Oil, Gas or Dry Hole) DRY HOLE

Date well completed 15 DECEMBER 19 62

Application for plugging filed 15 DECEMBER 19 62

Application for plugging approved 15 DECEMBER 19 62


Plugging commenced 15 DECEMBER 19 62

Plugging completed 15 DECEMBER 19 62

Reason for abandonment of well or producing formation DRY HOLE

If a producing well is abandoned, date of last production NONE 19

Was permission obtained from the Conservation Division or its agents before plugging was commenced? YES

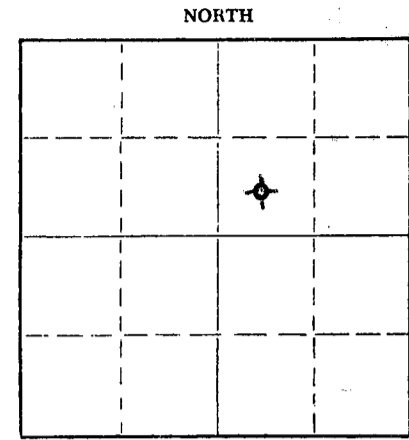

Locate well correctly on above Section Plat

Name of Conservation Agent who supervised plugging of this well ARCHIE ELVING
Producing formation NONE Depth to top Bottom Total Depth of Well 4614' RB Feet

Show depth and thickness of all water, oil and gas formations.

OIL, GAS OR WATER RECORDS

CASING RECORD

FORMATION	CONTENT	FROM	TO	SIZE	PUT IN	PULLED OUT
<u>SURFACE HOLE</u>	<u>WATER</u>	<u>SURFACE</u>	<u>280' RB</u>	<u>8 5/8" OD</u>	<u>275.34'</u>	<u>LEFT IN</u>
<u>(SEE ATTACHED LOG)</u>						

Describe in detail the manner in which the well was plugged, indicating where the mud fluid was placed and the method or methods used in introducing it into the hole. If cement or other plugs were used, state the character of same and depth placed, from feet to feet for each plug set.

FILLED HOLE WITH DRILLING MUD TO 180', SET PLUG AND CEMENTED WITH 20 SACKS CEMENT, FILLED HOLE WITH DRILLING MUD TO 40', SET PLUG AND CEMENTED TO SURFACE WITH 10 SACKS CEMENT, PUT 2 SACKS CEMENT IN RAT HOLE.

JAN 16 1963

CONSERVATION DIVISION
Wichita, Kansas

(If additional description is necessary, use BACK of this sheet)

Name of Plugging Contractor REX & MORRIS DRILLING COMPANY
Address P. O. BOX 334, EL DORADO, KANSAS

STATE OF KANSAS, COUNTY OF BUTLER, ss. A. H. FISHER

(employee of owner) or (owner or operator) of the above-described well, being first duly sworn on oath, says: That I have knowledge of the facts, statements, and matters herein contained and the log of the above-described well as filed and that the same are true and correct. So help me God.

(Signature) A. H. Fisher

P. O. BOX 334, EL DORADO, KANSAS
(Address)

SUBSCRIBED AND SWORN to before me this 10TH day of JANUARY 19 63

My commission expires 8 AUGUST 1966

ELIZABETH DESCHNER

Notary Public.



BINGER #1

Rex & Morris Drilling Company
and
Petroleum, Inc.

Total Depth: 4614
Contractor: Rex & Morris
Commenced: 12-5-62
Completed: 12-15-62
Initial Prod.: D. & A.

Location: C. SW NE
Section 2-26S-15W
Pratt County, Kansas
Casing Record:
8 5/8 @ 280' w/190 sacks

FORMATION	DEPTH
Surface Hole	280
Shale	970
Anhydrite	990
Shale and Salt	1815
Shale	1900
Lime and Shale	3325
Lime	3697
Lime and Shale	3830
Lime	4158
Lime and Shale	4220
Lime	4287
Chert Miss.	4305
Lime and Shale	4382
Lime	4540
Shale and Sand	4577
Lime	4614

RTD

RECEIVED
STATE CORPORATION COMMISSION
JAN 11 1963
CONSERVATION DIVISION
Wichita, Kansas

I hereby certify the foregoing statements are true and correct to the best of my knowledge and belief.

Rex & Morris Drilling Company

By Paul D. Koontz
Paul D. Koontz, Geologist

STATE OF KANSAS
COUNTY OF BUTLER, SS.

Subscribed and sworn to before me, a Notary Public, this 18th day of December, 1962.

Elizabeth Deschner
Elizabeth Deschner, Notary Public

My commission expires: August 8, 1966.

