

WELL PLUGGING RECORD


FORMATION PLUGGING RECORD

STATE OF KANSAS STATE CORPORATION COMMISSION

Give All Information Completely Make Required Affidavit Mail or Deliver Report to: Conservation Division State Corporation Commission 800 Bittling Building Wichita, Kansas

Strike out upper line when reporting plugging off formations.

NORTH

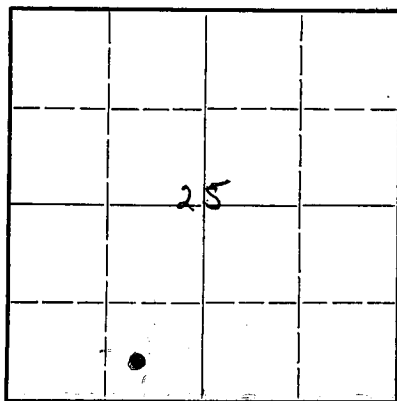

Locate well correctly on above Section Plat

Russell County. Sec. 25 Twp. 13 Rge. 15 (E) (W) Location as "NE1/4NW1/4SW1/4" or footage from lines. S/2 SW SWSW SW Lease Owner: Clyde G. Kissinger Lease Name: Sellens A Well No. #2 Office Address: Russell, Kansas Character of Well (completed as Oil, Gas or Dry Hole): Oil Date well completed: 2/19/47 Application for plugging filed: 11/10/47 Application for plugging approved: 11/11/47 Plugging commenced: Plugging completed: 11/15/48 Reason for abandonment of well or producing formation: non-productive

If a producing well is abandoned, date of last production: October 19. 47 Was permission obtained from the Conservation Division or its agents before plugging was commenced? Yes

Name of Conservation Agent who supervised plugging of this well: M. A. Rives Producing formation: K.C. Depth to top: 3145 Bottom: 3319 Total Depth of Well: 3320 Feet Show depth and thickness of all water, oil and gas formations.

OIL, GAS OR WATER RECORDS

CASING RECORD

Table with 7 columns: Formation, Content, From, To, Size, Put In, Pulled Out. Row 1: 5 1/2" set on top of Arbuckle at 3320 and was shot off at 2760 and pulled. There is 930 feet of 10" surface casing cemented from the top of the hole to 930 feet.

Describe in detail the manner in which the well was plugged, indicating where the mud fluid was placed and the method or methods used in introducing it into the hole. If cement or other plugs were used, state the character of same and depth placed, from... feet to... feet for each plug set.

We are not acquainted with the method used in plugging this well. The work was done by Wagner & Friar, Oklahoma City and supervised by a conservation agent. Any further information can be gotten by contacting Wagoner & Friar.

0323-1949

MAR 23 1949

STATE CORPORATION COMMISSION

(If additional description is necessary, use BACK of this sheet)

Correspondence regarding this well should be addressed to: Wagoner & Friar, Oklahoma City, Okla.

Address

STATE OF KANSAS, COUNTY OF Russell, ss.

Clyde G. Kissinger

(employee of owner) or (owner or operator) of the above-described well,

being first duly sworn on oath, says: That I have knowledge of the facts, statements, and matters herein contained and the log of the above-described well as filed and that the same are true and correct. So help me God.

(Signature)

Clyde G. Kissinger

Russell, Kansas (Address)

Wagoner & Friar Notary Public

SUBSCRIBED AND SWORN to before me this 22 day of

Sept. 20, 1950

My commission expires



February 18, 1947

DRILLING LOG

C. G. Kissinger, et al.,
133 1/2 West 3rd Street,
Hastings, Nebraska.

Lease: Sellens #2

County: Russell, Kansas
Sec. 25-13-15
Location: SW SE SW

Total Depth: 331 1/2'
Cores: 1-26-47 Comp: 2-11-47
Shot or Treated
Casing: 8 5/8" @ 932' 5 1/2" @ 331 1/2'

Contractors: Gabbert & Lindas
1316 Union National Bank Building,
Wichita 2, Kansas

Rotary T. D.: 331 1/2'

Figures Indicate Bottom of Formations:

0	to	115 Clay Streaks and Sand
115		530 Shale and Shells
530		590 Sticky Shale
590		610 Sand
610		923 Red Bed and Shale
923		963 Anhydrite
963		1080 Red Bed
1080		1300 Red Bed and Shells
1300		1665 Shale and Shells
1665		1873 Lime
1873		1915 Broken Lime Sandy
1915		2070 Lime
2070		2290 Shale and Lime
2290		2375 Broken Lime and Shale
2375		2475 Shale and Shells
2475		2575 Shale and Lime
2575		2620 Shale
2620		2728 Lime and Shale
2728		2737 Lime
2737		2784 Shale and Lime
2784		331 1/2 T. D. Lime

12-20-1948

STATE OF KANSAS)
COUNTY OF SEDGWICK) SS

I, the undersigned, being duly sworn on oath state that the above statement and log is true and correct record and log of the well drilled at the location above described.

GABBERT & LINDAS

By Scott Stucky

Subscribed and sworn to before me this 18th day of February, 1947

Catherine Dancy
Notary Public

My commission expires Mar. 25, 1948

