


WELL PLUGGING RECORD

Give All Information Completely
Make Required Affidavit
Mail or Deliver Report to:
Conservation Division
State Corporation Commission
800 Bitting Building
Wichita, Kansas

NORTH

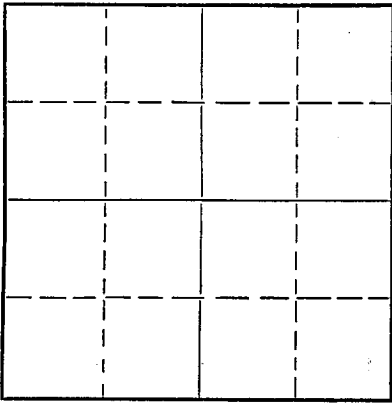

Locate well correctly on above
Section Flat

Russell County. Sec. 20 Twp. 13 Rge. (E) 14 (W)
Location as "NE/CNW $\frac{1}{4}$ SW $\frac{1}{4}$ " or footage from lines S/2 SW/4
Lease Owner Kim Oil Company
Lease Name Gernon Well No. 1
Office Address P. O. Box 468 Russell, Kansas
Character of Well (completed as Oil, Gas or Dry Hole) Oil
Date well completed 19 54
Application for plugging filed Feb. 20 19 52
Application for plugging approved Feb. 23 19 54
Plugging commenced Feb. 18 19 54
Plugging completed Feb. 22 19 54
Reason for abandonment of well or producing formation Depleted

If a producing well is abandoned, date of last production December 22 19 53
Was permission obtained from the Conservation Division or its agents before plugging was commenced? Yes

Name of Conservation Agent who supervised plugging of this well Warren Horner, Great Bend, Kansas
Producing formation Arbuckle Depth to top Bottom Total Depth of Well 3314 Feet
Show depth and thickness of all water, oil and gas formations.

OIL, GAS OR WATER RECORDS

CASING RECORD

Formation	Content	From	To	Size	Put In	Pulled Out
				8 5/8"	280'	None
				5 1/2"	3310'	2578'

Describe in detail the manner in which the well was plugged, indicating where the mud fluid was placed and the method or methods used in introducing it into the hole. If cement or other plugs were used, state the character of same and depth placed, from 3314 feet to 0 feet for each plug set.

Plugged back with crushed rock from 3314' to 3300'.
Dumped 5 sacks cement at 3300 W/balor, top of cement 3265'. Filled hole with mud to 285'. Set 10' Rock Bridged. Dump 15 sacks cement. Top of cement 223'. Fill with mud to 45'. Set 10' Rock bridge. Dumped 10 sacks cement for cap.

(If additional description is necessary, use BACK of this sheet)

Name of Plugging Contractor Miller Casing Pulling Co. 03-04-1954
Address Great Bend, Kansas

STATE OF KANSAS, COUNTY OF RUSSELL, ss.

(employee of owner) or (owner or operator) of the above-described well, being first duly sworn on-oath, says: That I have knowledge of the facts, statements, and matters herein contained and the log of the above-described well as filed and that the same are true and correct. So help me God.

PLUGGING
FILE SEC 20 T 13 R 14W
BOOK PAGE 15 LINE 2

(Signature)

[Signature]
Russell, Kansas
(Address)

SUBSCRIBED AND SWORN to before me this 26th day of February, 19 54

My commission expires Sept. 23, 1957

[Signature]
Notary Public.

15-167-00042-00-00

HONAKER DRILLING COMPANY
2008 Lakin
Great Bend, Kansas

August 6, 1952

DRILLERS LOG

Company: Richard M. Driscoll et al

Sec: 20-139-14W

Farm: Gernon No. 1

Loc: SW SW SW

Russell County, Kansas

Elev: 1873 D.F.

Total Depth: 3314'

Comm: 7-23-52

Comp: 8-4-52

Casing: 8-5/8" 221'

Contractor: Honaker Drilling Company

5-1/2" 3314'

0	15	Surface Soil	
15	200	Shale, Shells & Sand	
200	290	Shale, Lime & Shells	
290	305	Sand	
305	400	Shale	
400	435	Iron & Sand	
435	466	Shale & Sand	Cemented 8-5/8" casing at 221'
466	540	Sand & Shale	w/135 sacks cement & 1 sack
540	903	Red Red	Calcium Chloride.
903	943	Anhydrite	
943	1125	Red Shale	
1125	1570	Shale & Shells	
1570	1765	Lime & Shale	
1765	2045	Lime	
2045	2360	Shale & Lime	
2360	2415	Lime & Shale	
2415	2560	Shale & Lime	
2560	2770	Lime & Shale	
2770	2815	Lime Cherty	
2815	2853	Lime	
2853	2890	Hard Lime	
2890	2995	Lime	
2995	3120	Shale & Lime	
3120	3265	Lime	
3265	3314	Lime & Shale	Rotary T.D. Cemented 5-1/2" casing at 3314' w/100 sacks cement.

I certify that this is the true and correct copy of the above log, to the best of my knowledge.

By Joe G. Honaker

Subscribed and sworn to before me this 7 day of August 1952

Kenneth A. Fisher
Notary Public

My Commission Expires 6-25-55



PLUGGING
FILE SEC 20-139-14W
BOOK PAGE 15 LINE 9

02-25-1954