


WELL PLUGGING RECORD

Give All Information Completely  
Make Required Affidavit  
Mail or Deliver Report to:  
Conservation Division  
State Corporation Commission  
212 North Market, Insurance Bldg.  
Wichita, Kansas

Russell County, Sec. 22 Twp. 13 Rge. (E) 14 (W)

Location as "NE/CNW/SW" or footage from lines NE SE NE  
Lease Owner Nadel and Gussman  
Lease Name Driscoll Well No. 1  
Office Address 625 Union Center Building, Wichita, Kansas  
Character of Well (completed as Oil, Gas or Dry Hole) Dry Hole  
Date well completed February 8 19 61  
Application for plugging filed February 8 19 61  
Application for plugging approved February 8 19 61  
Plugging commenced February 8 19 61  
Plugging completed \_\_\_\_\_ 19 \_\_\_\_\_  
Reason for abandonment of well or producing formation \_\_\_\_\_

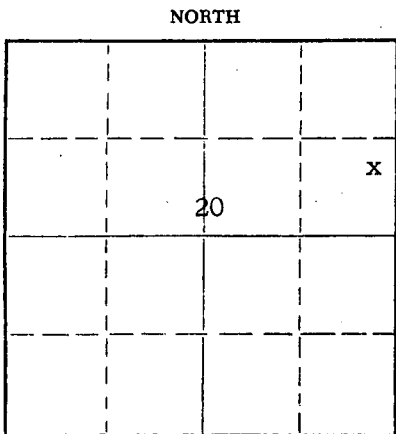

Locate well correctly on above Section Plat

If a producing well is abandoned, date of last production \_\_\_\_\_ 19 \_\_\_\_\_  
Was permission obtained from the Conservation Division or its agents before plugging was commenced? Yes

Name of Conservation Agent who supervised plugging of this well Mr. Truan  
Producing formation \_\_\_\_\_ Depth to top \_\_\_\_\_ Bottom \_\_\_\_\_ Total Depth of Well 3300' Feet  
Show depth and thickness of all water, oil and gas formations.

OIL, GAS OR WATER RECORDS

CASING RECORD

FORMATION	CONTENT	FROM	TO	SIZE	PUT IN	PULLED OUT
				8 5/8"	182'	None

Describe in detail the manner in which the well was plugged, indicating where the mud fluid was placed and the method or methods used in introducing it into the hole. If cement or other plugs were used, state the character of same and depth placed, from \_\_\_\_\_ feet to \_\_\_\_\_ feet for each plug set.

Filled hole with mud to 300' of top. Set first plug at 300' with 20 sacks of cement through drill pipe.  
Filled hole with mud to 180' of top. Set second plug with 20 sacks of cement pumped through drill pipe.  
Filled hole with mud to 40' of top. Set third plug at 40' with 10 sacks of cement pumped through drill pipe.

RECEIVED  
STATE CORP.  
MAR 20 1961  
03-16-1961  
CONSERVATION DIVISION  
Wichita, Kansas

(If additional description is necessary, use BACK of this sheet)

Name of Plugging Contractor \_\_\_\_\_  
Address \_\_\_\_\_

STATE OF Kansas, COUNTY OF Barton, ss.  
A. M. Jones (employee of owner) or (owner or operator) of the above-described well, being first duly sworn on oath, says: That I have knowledge of the facts, statements, and matters herein contained and the log of the above-described well as filed and that the same are true and correct. So help me God.

(Signature) A. M. Jones  
Box 106, Great Bend, Kansas (Address)

SUBSCRIBED AND SWORN TO before me this 14th day of February, 19 61

My commission expires April 11, 1963  
John W. Poos Notary Public.



WELL LOG

Date started 1-29-61  
Date completed 2-3-61

Driscoll #1  
Section 20, Township 13, Range 14W  
Russell County, Kansas

Set 182 ft. of 8 5/8" surface pipe  
cemented with 110 sacks of incore cement

Elevation	1818' KB
Anhydrite	867'
Heebner shale	2938' (-1120')
Lansing KC	2989' (-1171')
Conglomerate	3263' (-1445')
Arbuckle dolomite	3293' (-1475')
Total depth	3300' (-1482')

Dry Hole

- 0' - 182' Post rock shale and shells
- 182' - 250' Shale
- 250' - 325' Shale and shells
- 325' - 420' Sand
- 420' - 995' Shale and shells
- 995' - 3041' Lime and shale
- 3041' - 3120' Lime
- 3120' - 3267' Lime and shale
- 3267' - 3272' Arbuckle
- 3272' - 3293' Conglomerate
- 3293' - 3300' Arbuckle

RECEIVED  
STATE CORPORATION &  
MAR 16 1961  
CONSERVATION  
Wichita, K.

AFFIDAVIT

State of Kansas . . . . . County of Barton

I, A. M. Jones, certify that the above is a true and correct log as reflected  
by the Daily drilling reports of the Jones Drilling Company.

By: A. M. Jones  
A. M. Jones

Subscribed and sworn before me this 14th day of February, 1961.

John W. Poos  
John W. Poos Notary Public

My commission expires April 11, 1963.