

STATE OF KANSAS
STATE CORPORATION COMMISSION
Give All Information Completely
Make Required Affidavit
Mail or Deliver Report to:
Conservation Division
State Corporation Commission
800 Bittling Building
Wichita, Kansas

WELL PLUGGING RECORD

OR
FORMATION PLUGGING RECORD

Strike out upper line
when reporting plugging
of formations.

Ellis County, Sec. 17 Twp. 11 Rge. 17 (E) (W) X

Location as "NE 1/4 NW 1/4 SW 1/4" or footage from lines C- NL-SE-SE

Lease Owner Champlin Refining Company

Lease Name Hadley "D" Well No. 13

Office Address Enid, Oklahoma

Character of Well (completed as Oil, Gas or Dry Hole) Dry Hole

Date, well completed August 8, 1941

Application for plugging filed August 13 19 41

Application for plugging approved August 13 19 41


Plugging Commenced August 15 19 41

Plugging Completed August 15 19 41

Reason for abandonment of well or producing formation Dry Hole

If a producing well is abandoned, date of last production 19

Was permission obtained from the Conservation Division or its agents before plugging was commenced? Yes

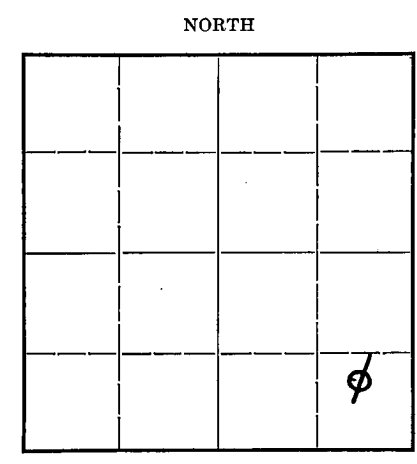

Locate well correctly on above Section Plat

Name of Conservation Agent who supervised plugging of this well C. T. Alexander

Producing formation None Depth to top 3691 Bottom 3697 Total Depth of Well 3697 Feet

Show depth and thickness of all water, oil and gas formations.

OIL, GAS OR WATER RECORDS



CASING RECORD

Formation	Content	From	To	Size	Put In	Pulled Out
				8 5/8	1067	None

Describe in detail the manner in which the well was plugged, indicating where the mud fluid was placed and the method or methods used in introducing it into the hole. If cement or other plugs were used, state the character of same and depth placed, from feet to feet for each plug set.

Application was made to retain this hole as a future water disposal well.

Plugging instructions were to fill the hole with heavy mud and screw bull plug in top of surface casing. Instructions followed, and well now completed.

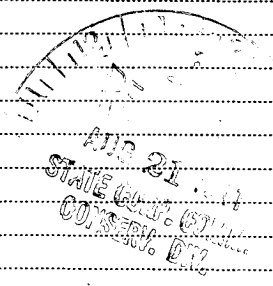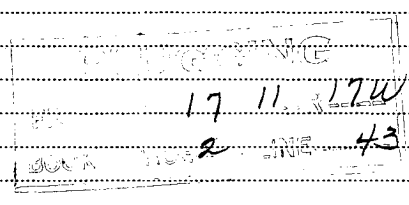

(If additional description is necessary, use BACK of this sheet)

Correspondence regarding this well should be addressed to Champlin Refining Company

Address Enid, Oklahoma

STATE OF Oklahoma, COUNTY OF Garfield, ss. F. C. Wentworth

(employee of owner) or (owner or operator) of the above-described well, being first duly sworn on oath, says: That I have knowledge of the facts, statements, and matters herein contained and the log of the above-described well as filed and that the same are true and correct. So help me God.

(Signature) Floyd C. Wentworth


Box 1078, Enid, Okla (Address)

SUBSCRIBED AND SWORN TO before me this 20 day of Aug, 19 41

Notary Public. [Signature]

My commission expires Dec 17 - 1941

640 Acres
N

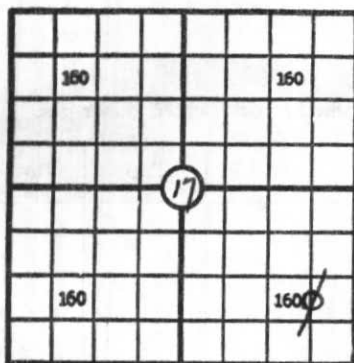

Locate Well Correctly

15-051-03863-0000
Form 1002

WELL RECORD KANSAS

Mail to Corporation Commission, Oklahoma City, Oklahoma

COUNTY Ellis SEC. 17 TWP. 11S RGE. 17W
 COMPANY OPERATING Champion Refining Company
 OFFICE ADDRESS Enid, Oklahoma
 FARM NAME Hadley WELL NO. 0-13
 DRILLING STARTED 7/29/41, 1941, DRILLING FINISHED 8/3/41, 1941
 DATE OF FIRST PRODUCTION _____ COMPLETED _____
 WELL LOCATED Center of SE 1/4 SE 1/4 990 North of South
 Line and 660 ft. from East of West Line of Quarter Section
 Elevation (Relative to sea level) DERRICK FLOOR _____ GROUND _____
 CHARACTER OF WELL (Oil, gas or dryhole) Dry

OIL OR GAS SANDS OR ZONES

Name	From	To	Name	From	To
1			4		
2	SEE REVERSE SIDE				
3			6		

WATER SANDS

Name	From	To	Water level	Name	From	To	Water level
1				4			
2	SEE REVERSE SIDE						
3				6			

CASING RECORD


Size	Wt.	Thds.	Make	Amount Set		Amount Pulled		Packer Record			
				Ft.	In.	Ft.	In.	Size	Length	Depth Set	Make
8 5/8"			O.D.	1081	11		None				

Liner Record: Amount _____ Kind _____ Top _____ Bottom _____

CEMENTING AND MUDDING

Size	Amount Set		Sacks Cement	Chemical		Method of Cementing	Amount	Mudding Method	Results (See Note)
	Ft.	In.		Gal.	Make				
8 5/8"	1081	11	350			Halliburton			

PLUGGING
FILE 17 11 R 174
BOOK 2 LINE 43

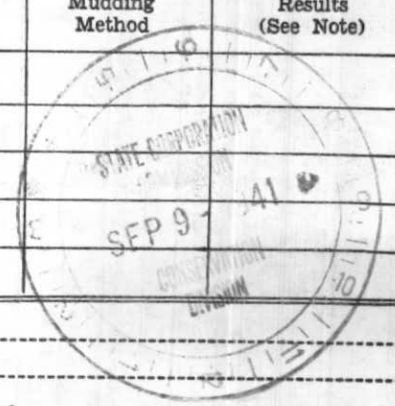

Note: What method was used to protect sands when outer strings were pulled? _____

NOTE: Were bottom hole plugs used? _____ If so, state kind, depth set and results obtained _____

TOOLS USED

Rotary tools were used from Top feet to T.D. feet, and from _____ feet to _____ feet
 Cable tools were used from _____ feet to _____ feet, and from _____ feet to _____ feet
 Type Rig _____

PRODUCTION DATA

Production first 24 hours dry hole bbls. Gravity _____ Emulsion _____ per cent., Water _____ per cent
 Production second 24 hours _____ bbls. Gravity _____ Emulsion _____ per cent., Water _____ per cent
 If gas well, cubic per 24 hours _____ Rock Pressure: Lbs. per square inch _____

I, the undersigned, being first duly sworn upon oath, state that this well record is true, correct and complete according to the records of this office and to the best of my knowledge and belief.

F. B. Wentworth
 Name and title of representative of company

Subscribed and sworn to before me this 14th day of August, 1941.

My Commission expires December 7, 1941

W. B. Miller
 Notary Public

FORMATION RECORD

Give detailed description and thickness of all formations drilled through and contents of sand, whether dry, water, oil or gas.

Formation	Top	Bottom	Formation	Top	Bottom
Sand shells	0	130			
Sand & shale & Pyrite	130	445			
Iron	445	510			
Pyrite & sand	510	516			
Shale	516	550			
Sand	550	720			
Red bed & shale	720	840			
Shale	840	1064			
Anhydrite	1064	1115			
Red bed & shale	1115	1400			
Salt & shale	1400	1550			
Shale & lime shells	1550	1680			
Lime shells & shale	1680	2000			
Lime & shale	2000	2070			
Lime	2070	2104			
Shale	2104	2115			
Lime & shale	2115	2265			
Shale	2265	2410			
Shale & shells	2410	2500			
Lime shells & shale	2500	2640			
Shale & lime	2640	2765			
Broken lime & shale	2765	2874			
Lime	2874	2890			
Lime & shale	2890	3363			
Shale, Lime & Conglom- erate debris (cored)	3363	3376			
Shale	3376	3383			
Conglomerate	3383	3390			
Shale & shells	3390	3450			
Conglomerate	3450	3595			
Shale	3595	3612			
Chert & dolomite	3612	3677			
Lime Chert & shale	3677	3687			
Shale	3687	3689			
Lime Arbuckle	3689	3691			
Cored(T.D.)	3691	3697	T.D.		