


15-051-03863-0001

STATE OF KANSAS
STATE CORPORATION COMMISSION

Form CP-4

WELL PLUGGING RECORD

Give All Information Completely
Make Required Affidavit
Mail or Deliver Report to:
Conservation Division
State Corporation Commission
P. O. Box 17027
Wichita, Kansas 67217
NORTH

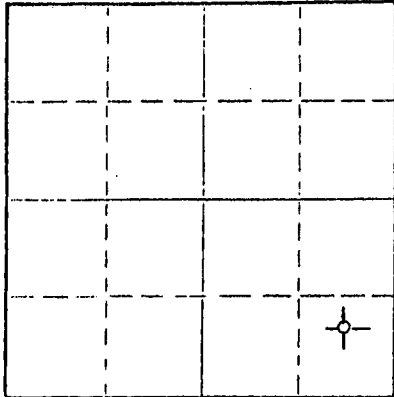

Locate well correctly on above
Section Plat

Ellis County, Sec. 17 Twp. 11 Rge. (E) 17 (W)

Location as "NE/CNW&SW" or footage from lines CN/2-SE-SE

Lease Owner Champlin Petroleum Company

Lease Name Hadley D Well No. 13

Office Address 2915 N. Lincoln, Okla. City, Okla. 73105

Character of Well (completed as Oil, Gas or Dry Hole) Saltwater Disposal Well

Date well completed October 15 19 42

Application for plugging filed February 10 19 72

Application for plugging approved February 11 19 72

Plugging commenced April 27 19 72

Plugging completed April 27 19 72

Reason for abandonment of well or producing formation

If a producing well is abandoned, date of last production 19

Was permission obtained from the Conservation Division or its agents before plugging was commenced? Yes

Name of Conservation Agent who supervised plugging of this well Leo Massey

Producing formation Depth to top Bottom Total Depth of Well 3697 Feet

Show depth and thickness of all water, oil and gas formations.

OIL, GAS OR WATER RECORDS

CASING RECORD

FORMATION	CONTENT	FROM	TO	SIZE	PUT IN	PULLED OUT
				8-5/8" OD	1079'	None
				4 1/2" OD	3695'	None

Describe in detail the manner in which the well was plugged, indicating where the mud fluid was placed and the method or methods used in introducing it into the hole. If cement or other plugs were used, state the character of same and depth placed, from feet to feet for each plug set.

Hooked onto 5 1/2" casing. Mixed and pumped 3 sacks of hulls and 30 sacks of gel followed with 120 sacks of Halliburton Light Cement. Well plugged and abandoned 4-27-72.

RECEIVED
STATE CORPORATION COMMISSION
JUN 19 1972
CONSERVATION DIVISION
Wichita, Kansas

(If additional description is necessary, use BACK of this sheet)

Name of Plugging Contractor Halliburton

Address Hays, Kansas

STATE OF Oklahoma COUNTY OF Oklahoma, ss.

N. K. Stivers (employee of owner) or (Notary Public) of the above-described

well, being first duly sworn on oath, says: That I have knowledge of the facts, statements, and matters herein contained and the log of the above-described well as filed and that the same are true and correct. So help me God.

(Signature) N.K. Stivers

2915 N. Lincoln, Oklahoma City, Okla. 73105

(Address)

SUBSCRIBED AND SWORN TO before me this 14th day of June 19 72

My commission expires 10-8-75

Notary Public

FORMATION RECORD

Give detailed description and thickness of all formations drilled through and contents of sand, whether dry, water, oil or gas.

Formation	Top	Bottom	Formation	Top	Bottom
Sand shells	0	130			
Sand & shale & Pyrite	130	445			
Iron	445	510			
Pyrite & sand	510	516			
Shale	516	550			
Sand	550	720			
Red bed & shale	720	840			
Shale	840	1064			
Anhydrite	1064	1115			
Red bed & shale	1115	1400			
Salt & shale	1400	1550			
Shale & lime shells	1550	1680			
Lime shells & shale	1680	2000			
Lime & shale	2000	2070			
Lime	2070	2104			
Shale	2104	2115			
Lime & shale	2115	2265			
Shale	2265	2410			
Shale & shells	2410	2500			
Lime shells & shale	2500	2640			
Shale & lime	2640	2765			
Broken lime & shale	2765	2874			
Lime	2874	2890			
Lime & shale	2890	3363			
Shale, Lime & Conglom- erate debris (cored)	3363	3376			
Shale	3376	3383			
Conglomerate	3383	3390			
Shale & shells	3390	3450			
Conglomerate	3450	3595			
Shale	3595	3612			
Chert & dolomite	3612	3677			
Lime Chert & shale	3677	3687			
Shale	3687	3689			
Lime Arbuckle	3689	3691			
Cored(T.D.)	3691	3697	T.D.		