


STATE OF KANSAS  
STATE CORPORATION COMMISSION

Form CP-4

Give All Information Completely  
Make Required Affidavit  
Mail or Deliver Report to:  
Conservation Division  
State Corporation Commission  
P. O. Box 17027  
Wichita, Kansas 67217  
NORTH

WELL PLUGGING RECORD

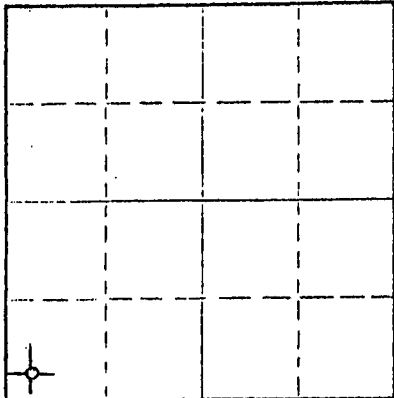

Locate well correctly on above  
Section Plat

Ellis County, Sec. 17 Twp. 11 Rge. (E) 17 (W)  
Location as "NE/CNW&SW" or footage from lines SW-SW-SW  
Lease Owner Champlin Petroleum Company  
Lease Name Hadley D Well No. 16  
Office Address 2915 N. Lincoln, Okla. City, Okla. 73105  
Character of Well (completed as Oil, Gas or Dry Hole) Oil  
Date well completed May 24 19 57  
Application for plugging filed February 4 19 72  
Application for plugging approved February 9 19 72  
Plugging commenced April 20 19 72  
Plugging completed April 20 19 72  
Reason for abandonment of well or producing formation Non-productive

If a producing well is abandoned, date of last production December 7 19 66  
Was permission obtained from the Conservation Division or its agents before plugging was commenced? Yes

Name of Conservation Agent who supervised plugging of this well Leo Massey  
Producing formation \_\_\_\_\_ Depth to top \_\_\_\_\_ Bottom \_\_\_\_\_ Total Depth of Well 3609 Feet  
Show depth and thickness of all water, oil and gas formations.

OIL, GAS OR WATER RECORDS

CASING RECORD

FORMATION	CONTENT	FROM	TO	SIZE	PUT IN	PULLED OUT
				8-5/8" OD	215'	None
				5 1/2" OD	3608'	None

Describe in detail the manner in which the well was plugged, indicating where the mud fluid was placed and the method or methods used in introducing it into the hole. If cement or other plugs were used, state the character of same and depth placed, from \_\_\_\_\_ feet to \_\_\_\_\_ feet for each plug set.

Ran 104 jts 2-3/8" tubing to 3175'. Mixed and pumped 1 sack of hulls and 25 sacks of gel followed with 25 sacks of Halliburton Light Cement. Cement plug from 2525' to 3175'. Pulled 2635' of tubing to 540'. Mud plug from 540' to 2635'. Mixed and pumped 60 sacks of Halliburton Light cement. Pulled remaining 540' of tubing. Cement plug from surface to 540'. Mixed and pumped 20 sacks of Halliburton light cement in annulus between the 5 1/2" and 8-5/8" casings.  
Well plugged and abandoned 4-20-72.

RECEIVED  
STATE CORPORATION COMMISSION  
JUN 19 1972  
CONSERVATION DIVISION  
Wichita, Kansas

(If additional description is necessary, use BACK of this sheet)  
Name of Plugging Contractor Halliburton  
Address Hays, Kansas

STATE OF Oklahoma COUNTY OF Oklahoma, ss.  
N. K. Stivers (employee of owner) or (owner or operator) of the above-described well, being first duly sworn on oath, says: That I have knowledge of the facts, statements, and matters herein contained and the log of the above-described well as filed and that the same are true and correct. So help me God.

(Signature) *N.K. Stivers*  
2915 N. Lincoln, Oklahoma City, Okla. 73105  
(Address)

SUBSCRIBED AND SWORN TO before me this 14th day of June, 19 72

My commission expires

10-8-75

*Notary Public*  
Notary Public.

TO KANSAS CORPORATION COMMISSION  
Conservation Division  
800 Bitting Building  
Wichita, Kansas


County Ellis SEC. 17 TWP. 11S RGE. 17W

COMPANY OPERATING Champlin oil & Refining Co.

OFFICE ADDRESS 306 Koch Building - Wichita, Kansas

FARM NAME Hadley "D" WELL NO. 16

WELL LOCATED SW SW SW Sec. 17-11S-17W

CHARACTER OF WELL Oil

DRILLING COMMENCED May 3, 1957 DRILLING COMPLETED May 17, 1957

SIZE	WEIGHT	THDS	MAKE	FT.	AMOUNT PULLED	CEMENT
8-5/8"	24#	8rd.	Smls.	215'	None	150 sks.
5-1/2"	14#	8 rd.	Smls.	3607'	None	150 sks.

FORMATION RECORD

TOPS	BOTTOM	TOPS	BOTTOM
	Shale	215	
	Shale & Shells	560	
	Sand	690	
	Pyride-Shale & Sand	773	
	Shale & Red Bed-Shells	1273	
	Anhy.	1303	
	Shale	1680	
	Red Bed - Shale	1840	
	Lime & Shale	2009	
	Shale & Lime	2219	
	Lime & Shale	2647	
	Shale	3003	
	Lime	3515	
	Cong. Sand & Lime	3543	
	Coring	3609, RTD	

RECEIVED  
STATE CORPORATION COMMISSION  
FEB 7 1957  
CONSERVATION DIVISION  
Wichita, Kansas

Subscribed and sworn to before me  
this 5 day of June, 1957  
My commission expires 2/22/61

J. W. Meyers  
Superintendent  
W. Kenneth Stivers  
Notary Public W. Kenneth Stivers