

STATE OF KANSAS
STATE CORPORATION COMMISSION

Form CP-4

Give All Information Completely
Make Required Affidavit
Mail or Deliver Report to:
Conservation Division
State Corporation Commission
212 No. Market
Wichita, Kansas 67202

WELL PLUGGING RECORD

Ellis County, Sec. 17 Twp. 11S Rge. 28E 17 (W)

Location as "NE/CNW%SW%" or footage from lines C N/2 N/2 SW/4

Lease Owner Champlin Petroleum Company

Lease Name Hadley "D" Well No. 17

Office Address P. O. Box 30, Ellinwood, Kansas 67526

Character of Well (completed as Oil, Gas or Dry Hole) Dry Hole

Date well completed March 23 19 70

Application for plugging filed March 25 19 70

Application for plugging approved March 24 (Verbal) 19 70


Plugging commenced March 24 19 70

Plugging completed March 24 19 70

Reason for abandonment of well or producing formation

If a producing well is abandoned, date of last production 19

Was permission obtained from the Conservation Division or its agents before plugging was commenced? Yes

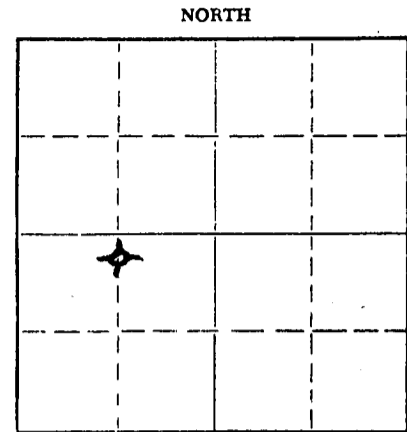

Locate well correctly on above Section Plat

Name of Conservation Agent who supervised plugging of this well Leo F. Massey

Producing formation Depth to top Bottom Total Depth of Well 3492 Feet

Show depth and thickness of all water, oil and gas formations.

OIL, GAS OR WATER RECORDS

CASING RECORD

FORMATION	CONTENT	FROM	TO	SIZE	PUT IN	PULLED OUT
				8 5/8 "	814'	None
RECEIVED STATE CORPORATION COMMISSION MAR 26 1970 CONSERVATION DIVISION Wichita, Kansas						

Describe in detail the manner in which the well was plugged, indicating where the mud fluid was placed and the method or methods used in introducing it into the hole. If cement or other plugs were used, state the character of same and depth placed, from feet to feet for each plug set.

Filled hole with mud from 3492' TD to 500' and pumped in 30 sacks cement then mud to 40' and pumped in 10 sacks of cement filling hole to base of cellar. Plugged rat hole with 2 sacks of cement. Hole plugged at 2:00 a.m.

Used Globe Cementing Company.

(If additional description is necessary, use BACK of this sheet)

Name of Plugging Contractor Red Tiger Drilling Company

Address 1720 Wichita Plaza, Wichita, Kansas

STATE OF Kansas, COUNTY OF Barton, ss. J. W. Meyers (employee of owner) or (owner or operator) of the above-described well, being first duly sworn on oath, says: That I have knowledge of the facts, statements, and matters herein contained and the log of the above-described well as filed and that the same are true and correct. So help me God.


(Signature) J. W. Meyers, District Operations Manager
P. O. Box 308, Ellinwood, Kansas 67526 (Address)

SUBSCRIBED AND SWORN TO before me this 25th day of March, 19 70

My commission expires

5/22/70

N. Kenneth Stivers Notary Public.

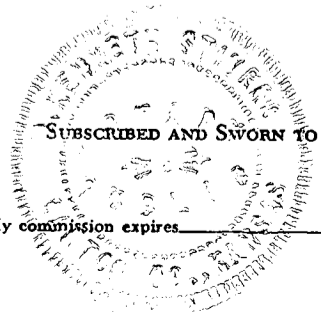

DRILLERS LOG

No. 17 Hadley "D"

CASING RECORD:	COMPANY:	DESCRIPTION:
8 5/8" @ 813'	Champlin Petroleum Company	C N/2 N/2 SW/4
w/375 sx cement	CONTRACTOR: Red Tiger Drilling Company	17-11S-17W
	COMMENCED: March 10, 1970	Ellis County, Kansas
TOTAL DEPTH: 3492'	COMPLETED: March 24, 1970	ELEVATION:

<u>FORMATION</u>	<u>FROM</u>	<u>TO</u>	<u>REMARKS</u>
Surf. Soil, Rocks, Clay	0	35	
Shale w/Sand Streaks	35	525	
Shale & Sand	525	573	
Shale	573	622	
Sand	622	778	
Shale	778	814	
Shale & Shells	814	1130	
Anhydrite	1130	1164	
Shale & Shells	1164	1697	
Lime & Shale	1697	2880	
Lime	2880	3055	
Shale	3055	3058	
Lime & Shale	3058	3075	
Lime	3075	3387	
Conglomerate	3387	3393	
Arbuckle	3393	3492	

RECEIVED
STATE CORPORATION COMMISSION
APR 1 - 1970
CONSERVATION DIVISION
Wichita, Kansas

I certify that this is a true and correct copy of the above log to the best of my knowledge.

RED TIGER DRILLING COMPANY

George A. Angle
George A. Angle

Subscribed and sworn to before me this 5th day of March, 1970.



Gloria Fawcett
Notary Public

My Commission Expires: 10/25/72