

15-051-19294-00-01

STATE OF KANSAS
STATE CORPORATION COMMISSION

Form CP-4


Give All Information Completely
Make Required Affidavit
Mail or Deliver Report to:
Conservation Division
State Corporation Commission
P. O. Box 17027

WELL PLUGGING RECORD

Wichita, Kansas 67217
NORTH

Ellis County, Sec. 17 Twp. 11S Rge. (E) 17 (W)

Location as "NE/CNW&SW" or footage from lines SW-SW-NE
Lease Owner CHAMPLIN PETROLEUM COMPANY
Lease Name Mock Well No. 1
Office Address 2915 N. Lincoln, Oklahoma City, Okla. 73105
Character of Well (completed as Oil, Gas or Dry Hole) Oil
Date well completed 7-7 19 41
Application for plugging filed 2-4 19 72
Application for plugging approved 2-9 19 72
Plugging commenced 4-19 19 72
Plugging completed 4-19 19 72
Reason for abandonment of well or producing formation depleted production -
uneconomical to operate
If a producing well is abandoned, date of last production 12-13 19 67
Was permission obtained from the Conservation Division or its agents before plugging was commenced? Yes

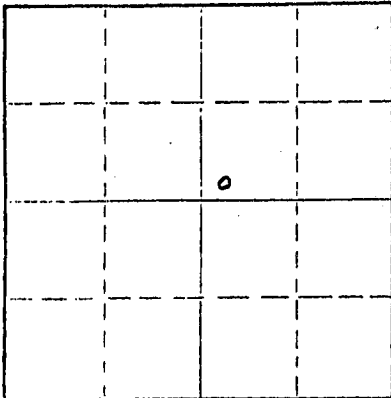

Locate well correctly on above Section Plat

Name of Conservation Agent who supervised plugging of this well Leo Massey - Box 582 - Hays, Kansas
Producing formation Arbuckle Lime Depth to top 3370 Bottom 3380 Total Depth of Well 3383 Feet
Show depth and thickness of all water, oil and gas formations.

OIL, GAS OR WATER RECORDS

CASING RECORD

FORMATION	CONTENT	FROM	TO	SIZE	PUT IN	PULLED OUT
Arbuckle Lime	Oil	3351	3365	16"	71'	None
Arbuckle Lime	Oil	3370	3380	10-3/4"	1060'	None
				7"	3351'	None
				5 1/2"	3316-3383	None

Describe in detail the manner in which the well was plugged, indicating where the mud fluid was placed and the method or methods used in introducing it into the hole. If cement or other plugs were used, state the character of same and depth placed, from _____ feet to _____ feet for each plug set.

Plug Back T.D. @ 3381'. April 19, 1972, ran 104 jts. 2-3/8" tubing to 3175'. Mixed and pumped 1 sack of hulls and 45 sacks of gel followed with 35 sacks of Halliburton Light Cement. Cement plug from 2965' to 3175'. Pulled 2815' of tubing to 360'. Mud from 360' to 2965'. Mixed and pumped 60 sacks of Halliburton Light Cement. Pulled remaining 360' of tubing cement plug from surface to 360'. Could not pump any cement in annulus between 7" and 9-5/8" casings. Well plugged and abandoned at 2:00 P.M. on 4-19-72.

RECEIVED STATE CORPORATION COMMISSION
MAY 22 1972 CONSERVATION DIVISION
Wichita, Kansas
RECEIVED STATE CORPORATION COMMISSION
JUN 2 1972 CONSERVATION DIVISION
Wichita, Kansas

(If additional description is necessary, use BACK of this sheet)
Name of Plugging Contractor Bill's Well Service and Halliburton
Address Box 42, Codell, Kansas

STATE OF Oklahoma COUNTY OF Oklahoma, ss.
Harold E. Melvin (employee of owner) or (owner or operator) of the above-described

well, being first duly sworn on oath, says: That I have knowledge of the facts, statements, and matters herein contained and the log of the above-described well as filed and that the same are true and correct. So help me God.

(Signature) H.E. Melvin
2915 North Lincoln, Oklahoma City, Okla. 73105
(Address)

SUBSCRIBED AND SWORN to before me this 3rd day of May, 1972

My commission expires 10-8-75
Notary Public.