# RECEIVED OCT 2 7 2010

### KANSAS CORPORATION COMMISSION OIL & GAS CONSERVATION DIVISION

Form CP-1 March 2010 This Form must be Typed Form must be Signed All blanks must be Filled

#### KCC WICHITA

#### WELL PLUGGING APPLICATION Form KSONA-1, Certification of Compliance with the Kansas Surface Owner Notification Act,

•	MUST be submitted with this form.
OPERATOR: License #: 5427	API No. 15 - 047 - 00373-000( 2
Name:D.R.LAUCK OIL CO.INC.	If pre 1967, supply original completion date: July, 18, 1959
Address 1: P.O.Box 488	Spot Description: C-NW-NW
Address 2: 110 N Main	
City: <u>Ellinwood</u> State: <u>KS</u> Zip: .	67526 + 660176/3 Feet from North / South Line of Section
Contact Person: Melvin G Urban	Feet from East 12 West Line of Seption
Phone: (620 ) 564-2013 Cell (620)793-	1 Oolages Calculated from Hodical Calculate Calculate
Filotie. (	County: Edwards
	Lease Name: Johnson Well #: 1
5,105, 5,15.	D&A Cathodic Water Supply Well Other:
x SWD Permit#:	ENHR Permit #: Gas Storage Permit #: _D-7302
Conductor Casing Size: Set	at: Cemented with: Sacks
Surface Casing Size: 10 3/4 " Set	at: 338! Cemented with: 225, Sacks
Production Casing Size: Set	at: 4731 Cemented with: 75Reg 1000 Latex Sacks
List (ALL) Perforations and Bridge Plug Sets:	
4372 to 438260 holes	&43 <b>4333</b> *4&654345*
Elevation: 2353 ( G.L. / [3/K.B.) T.D.: 4790 *	(Stone Corral Pormation)
Condition of Well: Good Poor X Junk in Hole	Casing Leak at:
Proposed Method of Plugging (attach a separate page if additional s	
Pulled 2850' 2 3/8" V.I.P. li Will try to fish tubing.	ned tubing 1170' tubing left in well.
Is Well Log attached to this application?	Is ACO-1 filed? Yes No ?
If ACO-1 not filed, explain why:	
	A Development of the Company to Commission
	5-101 et. seq. and the Rules and Regulations of the State Corporation Commission
	tions:Melvin_G_Urban  City:Ellinwood State: _KS Zip67526 +
Address: 110 N Main Phone: (620) 564-2013 or (620) 793-2	712
01500	Mikes Testing & Salvage Inc
	Name: Mikes Testing & Salvage Inc.
Address 1: P.O. Box 467	Address 2: State <sup>KS</sup> zip:67524+
Phone: (620) 938-2943	
Proposed Date of Plugging (if known): unknown	
	de de la Constanció America
Payment of the Plugging Fee (K.A.R. 82-3-118) will be guarant	teed by Operator of Agent  On a large hand a
Date: 10-26-10 Authorized Operator / Agent: —	(Signature)

# RECEIVED OCT 2 7 2010 KCC WICHITA

#### KANSAS CORPORATION COMMISSION OIL & GAS CONSERVATION DIVISION

Form KSONA-1 July 2010 Form Must Be Typed Form must be Signed All blanks must be Filled

## CERTIFICATION OF COMPLIANCE WITH THE KANSAS SURFACE OWNER NOTIFICATION ACT

This form must be submitted with all Forms C-1 (Notice of Intent to Drill); CB-1 (Cathodic Protection Borehole Intent); T-1 (Request for Change of Operator Transfer of Injection or Surface Pit Permit); and CP-1 (Well Plugging Application).


Any such form submitted without an accompanying Form KSONA-1 will be returned.

OPERATOR: License #5427	Well Location:
D P Lauck Oil Co Inc	C - NW - NW Sec25 Twp. 25 S. R. 16 East West
Address 1: 110 N.Main ST.	County: Edwards
Address 2:	Lease Name: Johnson Well #: 1
City: Ellinwood State: KS. zip: 67526 +	If filing a Form T-1 for multiple wells on a lease, enter the legal description of the lease below:
Contact Person: Melvin G Urban	
Phone: ( 620 ) 564-2013 Fax: ( 620 ) 564- 3882	
Email Address:	
Surface Owner Information:	
Name: John Flick	When filing a Form T-1 involving multiple surface owners, attach an additional sheet listing all of the information to the left for each surface owner. Surface owner information can be found in the records of the register of deeds for the county, and in the real estate property tax records of the county treasurer.
Address 1: _3617 Gunnison Drive	
Address 2: Lawrence Kansas 66049	
City: State: Zip:+	
the KCC with a plat showing the predicted locations of lease roads, tank	dic Protection Borehole Intent), you must supply the surface owners and a batteries, pipelines, and electrical lines. The locations shown on the plat In the Form C-1 plat, Form CB-1 plat, or a separate plat may be submitted.
Select one of the following:	
owner(s) of the land upon which the subject well is or will be l	act (House Bill 2032), I have provided the following to the surface ocated: 1) a copy of the Form C-1, Form CB-1, Form T-1, or Form being filed is a Form C-1 or Form CB-1, the plat(s) required by this nd email address.
I have not provided this information to the surface owner(s). I a KCC will be required to send this information to the surface ov task, I acknowledge that I am being charged a \$30.00 handling	cknowledge that, because I have not provided this information, the vner(s). To mitigate the additional cost of the KCC performing this I fee, payable to the KCC, which is enclosed with this form.
If choosing the second option, submit payment of the \$30.00 handling form and the associated Form C-1, Form CB-1, Form T-1, or Form CP-	fee with this form. If the fee is not received with this form, the KSONA-1 will be returned.
I hereby certify that the statements made herein are true and correct to Date: Oct. 26, 2010 Signature of Operator or Agent:	the best of my knowledge and belief.  Title: Production Supt.

#### BAKER OIL TOOLS, INC.

Operator D.R.LAUCK OIL CO.INC.

SERVING THE WORLD

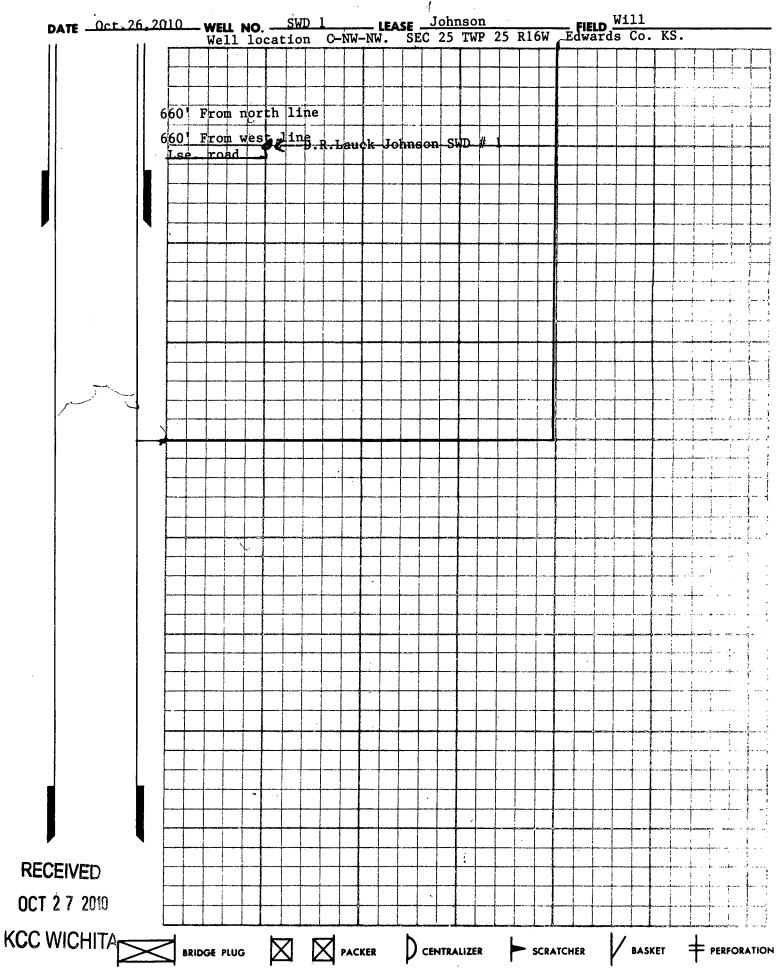



Mark Parkinson, Governor Thomas E. Wright, Chairman, Joseph F. Harkins, Commissioner, Ward Loyd, Commissioner

#### NOTICE OF RECEIPT OF WELL PLUGGING APPLICATION (CP-1)

D. R. LAUCK OIL CO., INC. 344 S LAURA WICHITA, KS 67211-1517

October 29, 2010

Re: JOHNSON #1

API 15-047-00373-00-01

25-25S-16W, 4613 FSL 4779 FEL EDWARDS COUNTY, KANSAS

#### Dear Operator:

This letter is to notify you that the Conservation Division has received your plugging proposal, form CP-1, for the above well and has reviewed the proposal for completeness. The central office will now forward your CP-1 to the district office listed below for review of the proposed plugging method. Please contact the district office for approval of your proposed plugging method at least five (5) days before plugging the well, pursuant to K.A.R. 82-3-113(b). If a workover pit will be used during the plugging of the well it must be permitted. A CDP-1 form must be filed and approved prior to the use of the pit in accordance with K.A.R. 82-3-600.

The Conservation Division's review of form CP-1, either in the central or district office, does not include an inquiry into well ownership or the filing operator's legal right to plug the well. This notice in no way constitutes authorization to plug the above well by persons not having legal rights of ownership or interest in the well.

This notice is void after April 27, 2011. The CP-1 filing does not bring the above well into compliance with K.A.R. 82-3-111 with regard to the Commission's temporary abandonment requirements.

Sincerely,

Steve Bond

Steve Bond

**Production Department Supervisor** 

District: #1 210 E Frontview, Suite A Dodge City, KS 67801 (620) 225-8888