

STATE OF KANSAS
STATE CORPORATION COMMISSION

Give All Information Completely
Make Required Affidavit
Mail or Deliver Report to:
Conservation Division
State Corporation Commission,
800 Bitting Building
Wichita, Kansas

WELL PLUGGING RECORD
OR
FORMATION PLUGGING RECORD
Strike out upper line when reporting plugging of formations.

Barber County. Sec. 23 Twp. 33 Rge. 13 (E) (W) X

Location as "NE 1/4 NW 1/4 SW 1/4" or footage from lines C-E 1/2 of S.E. 1/4

Lease Owner Barbara Oil Co.

Lease Name Rodgers #1 Well No. 1

Office Address 33 South Clark St. Chicago Ill.

Character of Well (Completed as Oil, Gas or Dry Hole) Dry Hole

Date, well completed April 19th, 8Am. 193 7

Application for plugging filed April 21st, 193 7

Application for plugging approved April 21st, 1937 193


Plugging Commenced April 23rd, 193 7

Plugging Completed April 25th, 12 Noon 193 7

Reason for abandonment of well or producing formation Dry Hole H.F.W. @ 4957

If a producing well is abandoned, date of last production -- 193

Was permission obtained from the Conservation Division or its agents before plugging was commenced? Yes

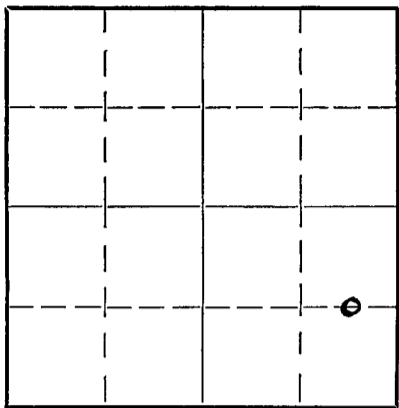

Locate well correctly on above Section Plat

Name of Conservation Agent who supervised plugging of this well Hal Smith

Producing formation No show of oil or gas at anytime Bottom Total Depth of Well 4957 Feet

Show depth and thickness of all water, oil and gas formations.

OIL, GAS OR WATER RECORDS


CASING RECORD

Formation	Content	From	To	Size	Put In	Pulled Out
Chat or chert	Dry	4445	4523	13" O.D.	279	None
Viola Lime	Dry	4825	4900	7" O.D.	4422	2512
Wilcox	Dry- H.F.W.	4952	4957			

Describe in detail the manner in which the well was plugged, indicating where the mud fluid was placed and the method or methods used in introducing it into the hole. If cement or other plugs were used, state the character of same and depth placed, from.....feet to

feet for each plug set.
Cement from 4882 to 4957 Put in with dump bailer
heavy rotary mud from 4300 to 4882-- put in with stem jet befor starting pipe
Heavy rotary mud from 270 to 4300 put in with jet after pulling pipe
Bridge at 260 to 270 cement put in with dump bailer from 245 to 260
filled with soil from 225 25 to 245- cement from 5 to 25

Complete Loge of well attached.

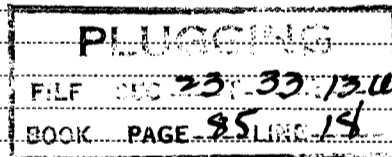

(If additional description is necessary use BACK of this sheet)

Correspondence regarding this well should be addressed to Barbara Oil Co. % F.R. Rodgers
Address Medicine, Lodge Kansas

STATE OF Kansas COUNTY OF Barber
F.R. Rodgers (employee of owner) or (owner or operator) of the above-described well,

being first duly sworn on oath, says: That I have knowledge of the facts, statements, and matters herein contained and the log of the above-described well as filed and that the same are true and correct. So help me God.

(Signature) H.R. Rodgers

Medicine Lodge Kansas (Address)

SUBSCRIBED AND SWORN to before me this 26 day of April, 1937

My commission expires October 2, 1939 Ray D. Luce Notary Public.

Rodgers #1 C. E $\frac{1}{2}$ of S.E. $\frac{1}{4}$ -- 23-33-13 W. Barber County
 Elevation By Frank Anderson 1533 Drilling by Rose-Spring
 Cellar by Co.--- Pits by Lee Simpson--- Rig by Mike Harper
 Cementing by Halliburton

Location made Jan, 12th, 1937

Feb. 21st, 1937-- Set 279 ft. 50# 13" O.D. surface pipe- 240 Sks Victor cement
 " 25th, 1937-- Start drilling under surface pipe @ 4. Pm.
 April 2nd, 1937-- Set 4422' 7" O.D. Seamless casing, 350 Sks. Victor cement
 April 9th, 1937-- Bail mud
 April 10th, drill cement
 April 19th, 1937-- complete drilling H.F.W. in Wilcox @ 8 Am.

-Rotary Log-

0	70	Red rock	3225	3240	Sandy lime
70	150	Red bed & shale	3240	3265	Shale & lime
150	383	Shale & gyp shell,s	3275	3320	Lime
283	360	Shale & shell,s	3320	3340	Broken lime
360	1235	Shale & gyp shell,s	3340	3355	Lime
1235	1370	Shale & salt	3355	3360	Hard sand
1370	1500	Shale lime & gyp	3360	3370	Sandy lime
1500	1640	Shale & salt	3370	3420	Shale & lime
1640	1695	Shale & gyp	3420	3430	Shale
1695	1795	Shale lime & gyp	3430	3433	Lime
1795	1885	Lime & gyp	3433	3435	Shale & lime
1885	1945	Lime	3435	3500	Sticky shale
1945	1950	Sand	3500	3515	Shale & lime shell,s
1950	2000	Shale & lime	3515	3560	Sticky shale & shell,s
2000	2100	Hard sand lime	3560	3565	Sticky shale
2100	2110	Shale & lime	3565	3605	Shale & lime
2110	2115	Soft sand	3605	3750	Shale
2115	2135	Sandy shale & lime	3750	3772	Sandy shale
2135	2145	Shale & lime	3772	3810	Sand & shale break,s
2145	2175	Sandy shale	3810	3820	Sand
2175	2270	Broken lime	3820	3825	Hard sand
2270	2325	Shale & lime	3825	3840	Sandy shale & broken lime
2325	2355	Shale	3840	3860	Sandy shale
2355	2375	Shale & lime	3860	3865	Sandy shale
2375	2380	Sticky shale & lime	3865	3890	Sandy shale & lime
2380	2425	Sandy shale & lime	3890	3925	Sandy shale
2425	2480	Shale	3925	3935	Shale
2480	2490	Sticky shale	3935	3947	Broken lime
2490	2555	Shale & lime	3947	3965	Hard lime
2555	2590	Sticky shale	3965	3975	Broken lime
2590	2610	Sandy shale	3975	4045	Lime
2610	2545	Sandy lime & shale	4045	4050	Hard sandy lime
2645	2690	Lime & shale	4050	4149	Lime
2690	2750	Broken lime	4149	4180	Broken lime
2750	2800	Sandy lime	4180	4207	Lime
2800	2810	Shale	4207	4221	Sandy lime
2810	2855	Shale & lime	4221	4229	Lime
2855	2920	Broken lime	4229	4240	Shale & lime
2920	2975	Shale	4240	4270	Broken lime
2975	2985	Shale & lime	4270	4280	Shale & lime
2985	3015	Sticky shale	4280	4282	Sandy lime
3015	3034	Sandy lime	4282	4305	Broken lime
3034	3055	Lime	4305	4327	Lime
3055	3085	Shale	4327	4341	Shale
3085	3100	Broken lime	4341	4351	Lime
3100	3130	Lime	4351	Shale & lime 4380	Shale & lime
3130	3165	Sandy lime	4380	4405	Broken lime
3165	3215	lime	4405	4424	Broken lime & shale
3215	3225	Sandy lime			

23 33 13W

PAGE-85 18

Rodgers #1

-Cable tool log

4424	4427	Lime
4427	4436	Shale
4436	4442	Lime hard
4442	4445	Shale green
4445	4523	Lime & chert
4523	4550	Sandy shale
4550	4580	Lime
4580	4582	Red rock
4582	4711	Lime
4711	4718	Shale blue
4718	4723	Lime
4723	4752	Shale black sandy
4752	4818	Shale black
4818	4825	Shale black sandy
4825	4839	Sandy chatty lime
4839	4850	Brown sandy lime
4850	4900	Brown sandy lime
4900	4925	Gray sandy lime
4925	4950	Shale blue
4950	4952	Lime sandy
4952	4955	Sand salty
4955	4957	Sand-----

H.F.W.

Total depth. 4957

Plugging completed April, 25th, 1937

23 33 13W
PAGE-85 18

Signed.

Barbara Oil Co.

By.

F.R. Rodgers
Field Supt.

F.R.R.

State of Kansas County of Barber S.S.
 F. R. Rodgers, Employee of owner, of the above described well being first duly sworn on oath, says: That I have knowledge of the facts, statements, and matters herein contained and the log of the above described well as filed and that the same are true and correct.
 So help me God

F.R. Rodgers

Subscribed and sworn to before me this 26th day of April 1937



Ray J. Jones
Notary Public

My Comm expires Oct 2, 1939