

STATE OF KANSAS
STATE CORPORATION COMMISSION


WELL PLUGGING RECORD
OR
FORMATION PLUGGING RECORD

RECEIVED
MAY 16 1936
Strike out upper line when reporting plugging of formations.
BY _____

Give All Information Completely
Make Required Affidavit
Mail or Deliver Report to:
Conservation Division
State Corporation Commission,
800 Bitting Building,
Wichita, Kansas

C-Ne $\frac{1}{4}$ -Ne $\frac{1}{4}$ Barber County. Sec. 23. Twp. 33. Rge. 13(E) (W) X

NORTH

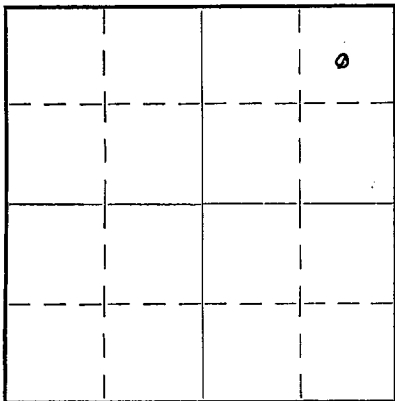

Locate well correctly on above Section Plat

Location as "NE $\frac{1}{4}$ NW $\frac{1}{4}$ SW $\frac{1}{4}$ " or footage from lines
Lease Owner Barbara Oil Co.
Lease Name Angell
Office Address 33 South Clark St Chicago Ill. Well No. 2
Character of Well (Completed as Oil, Gas or Dry Hole) Dry hole
Date, well completed April, 27th, 1936
Application for plugging filed April, 28th, 1936
Application for plugging approved April, 29th, 1936
Plugging Commenced April, 29th, 1936 1936
Plugging Completed May, 10th, 1936
Reason for abandonment of well or producing formation on show of Gas and show of oil, either was insufficient to make producer
If a producing well is abandoned, date of last production _____ 1936
Was permission obtained from the Conservation Division or its agents before plugging was commenced? _____

Name of Conservation Agent who supervised plugging of this well Hal. Smith
Producing formation _____ Depth to top _____ Bottom _____ Total Depth of Well 4937 Feet
Show depth and thickness of all water, oil and gas formations.

OIL, GAS OR WATER RECORDS

CASING RECORD

Formation	Content	From	To	Size	Put In	Pulled Out
<u>Chat</u>	<u>Show gas</u>	<u>4457</u>	<u>4465</u>	<u>15$\frac{1}{2}$"</u>	<u>122</u>	<u>0-cement to top</u>
<u>Sand & Sandy lime</u>	<u>show oil</u>	<u>4918'</u>	<u>4923</u>	<u>8$\frac{1}{4}$"</u>	<u>4406'</u>	<u>1698' 800 sex cement</u>
<u>Sand white hard</u>	<u>hole full water</u>	<u>4936</u>	<u>4937</u>			

Describe in detail the manner in which the well was plugged, indicating where the mud fluid was placed and the method or methods used in introducing it into the hole. If cement or other-plugs were used, state the character of same and depth placed, from _____ feet to _____ feet for each plug set.

Solid cement set with dump bailer, from 4887' to 4937'
Shale mud from 4502' to 4887'
solid cement set with dump bailer, from 4424' to 4502'
Shale mud from, 235' to 4424'
Solid cement set with dump bailer, from 215' to 235'
Shale mud from 10' to 215'
Solid cement from 0 to 10', mixed and put in by hand from top.

PLUGGING
FILE SEC 23-33-134
BOOK PAGE 43 LINE 30

(If additional description is necessary use BACK of this sheet)
Correspondence regarding this well should be addressed to Barbara Oil Co
Address Medicine, Lodge, Kansas

STATE OF Kansas, COUNTY OF Barber, ss.
A.R. Rodgus (employee of owner) or (owner or operator) of the above-described well,
being first duly sworn on oath, says: That I have knowledge of the facts, statements, and matters herein contained and the log of the above-described well as filed and that the same are true and correct. So help me God.

(Signature) A.R. Rodgus
Medicine Lodge Kansas
(Address) May 1936

SUBSCRIBED AND SWORN to before me this 15 day of May, 1936

My commission expires Oct 2, 1939
A. Ray & Sons Notary Public.